


T.18S.,R.45E.,W.M.

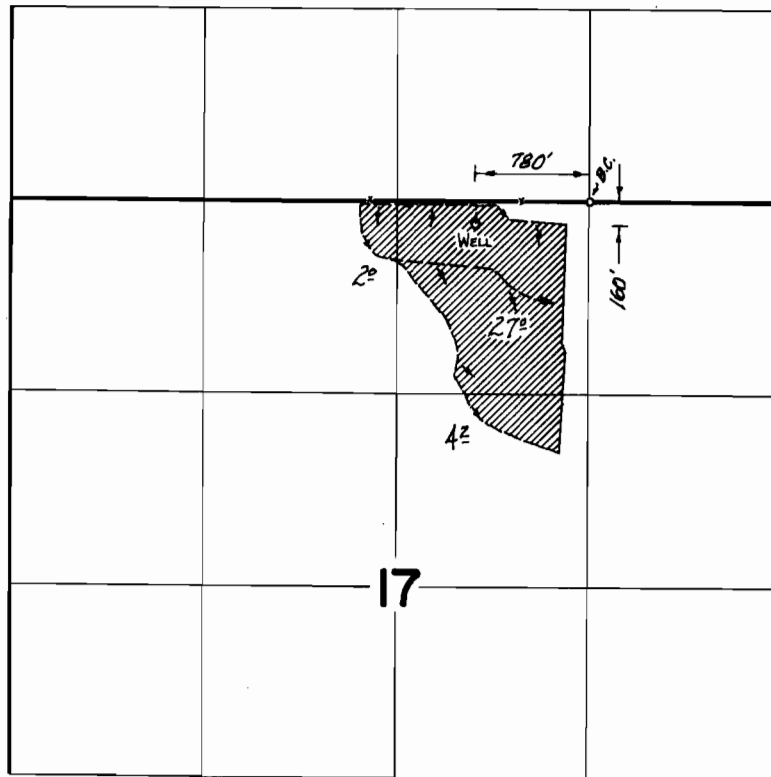

**FINAL PROOF SURVEY**  
UNDER

Application No. G-3480 Permit No. G-3281  
IN NAME OF

ROY BEAL HOOD & ILEAN HOOD

Surveyed May 22, 1973, by D. NORBY