


T.24 S. R.38 E. W.M.

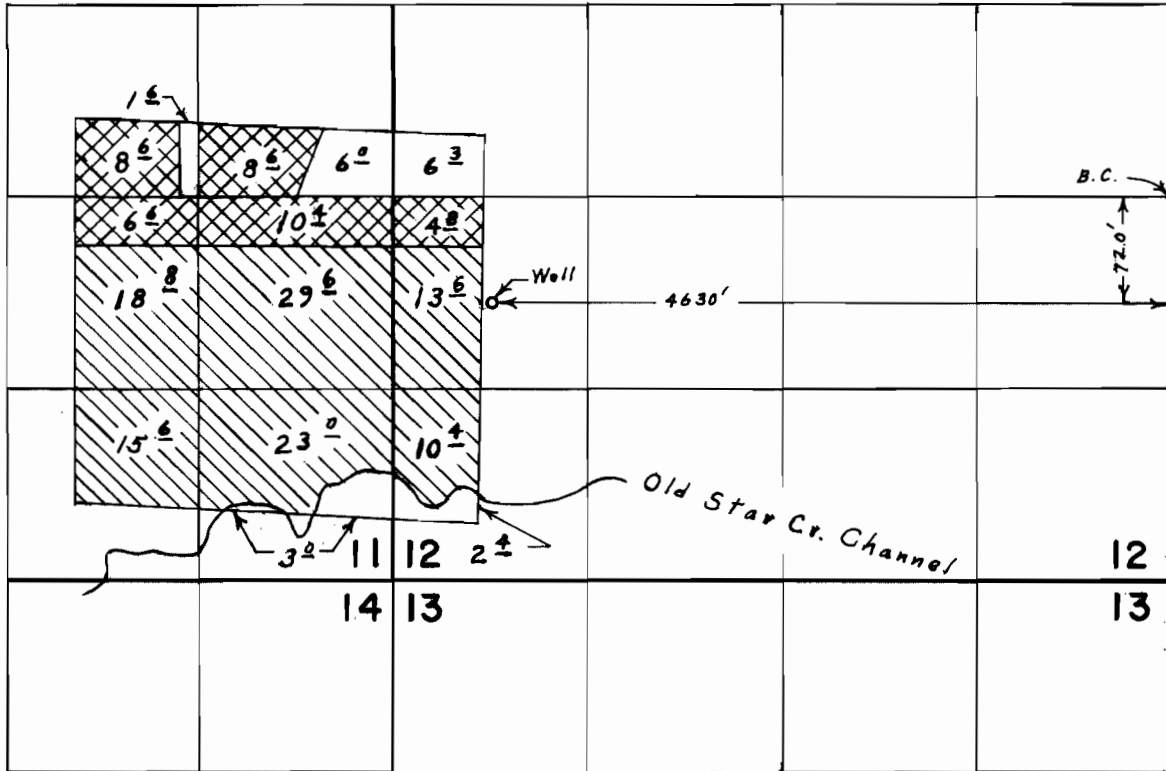

Primary
 Supplemental overacreage
 Supplemental allowed

FINAL PROOF SURVEY UNDER

Application No. G-3948 Permit No. G-3705
IN NAME OF

ROSS H. LEVANGER

Surveyed Aug. 27, 1973, by L. E. Gould