


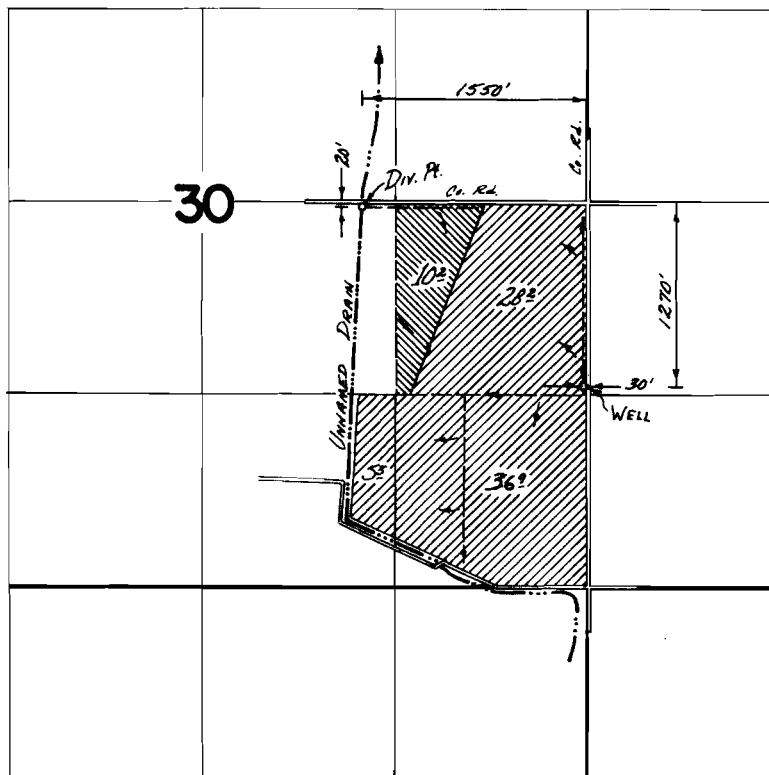

T.15S.,R.47E.,W.M.



**FINAL PROOF SURVEY**  
UNDER

G-4232                      G-3995   
Application No. 44487    Permit No. 33271   
IN NAME OF

HARRY G. & PEARL R. FRASIER

Surveyed May 30 1973, by D. Norby