


T.18S.,R.47E.,W.M.

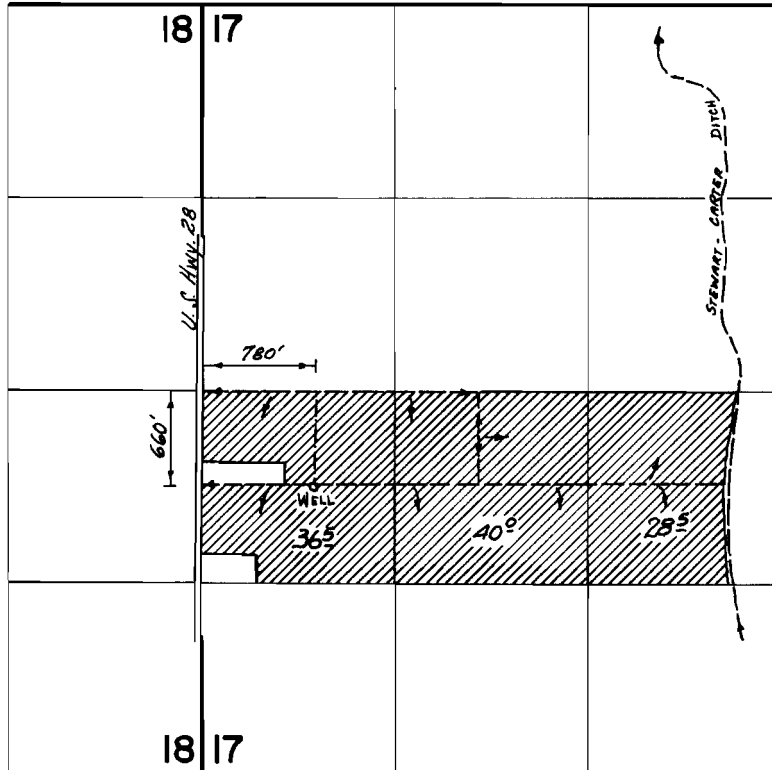

FINAL PROOF SURVEY
UNDER

Application No. G-4438 Permit No. G-4181
IN NAME OF

UCHIDA BROS.

Surveyed May 25 1973, by D. Noray