


T.18 S. R.47 E. W.M.

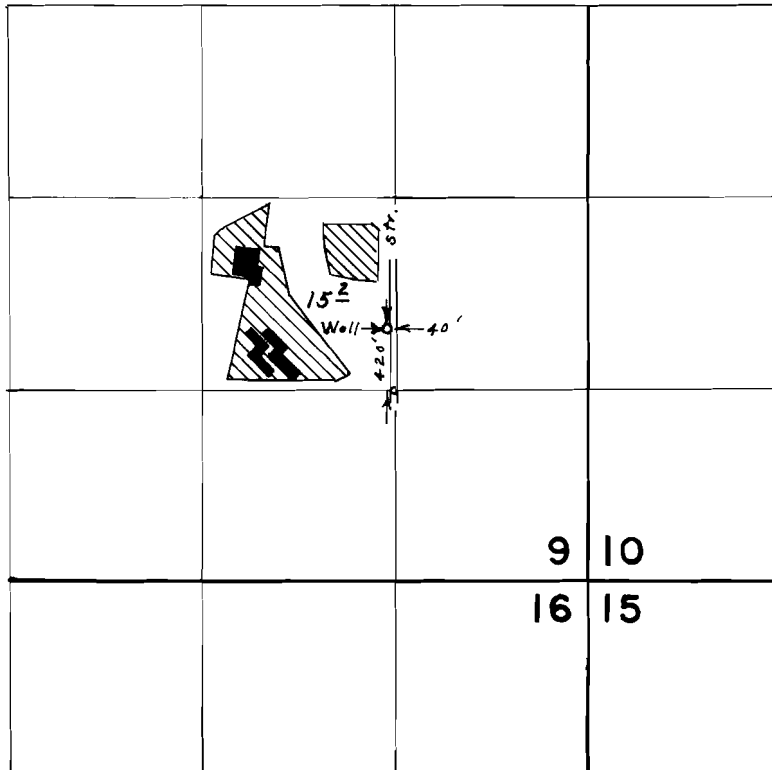

FINAL PROOF SURVEY
UNDER

Application No. G-4447 Permit No. G-4193
IN NAME OF

TREASURE VALLEY COMMUNITY COLLEGE

Surveyed Aug. 28, 1973, by L. E. Gould