


T.18S.R.43E.W.M.

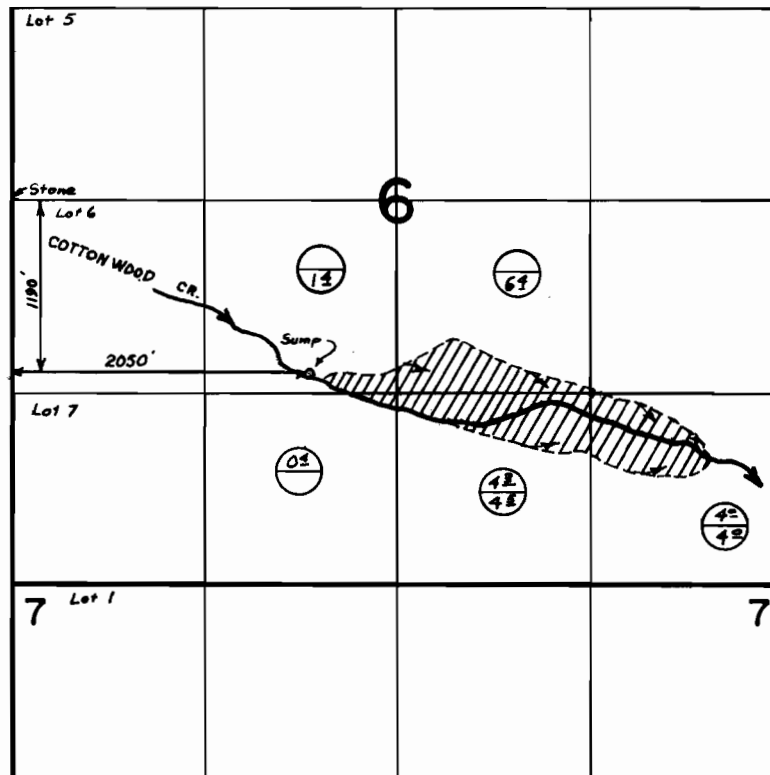

○ PRIMARY
— SUPPLEMENTAL

FINAL PROOF SURVEY
UNDER

Application No. G-4626 Permit No. G-4351
IN NAME OF

GROVER C. FOSTER

Surveyed AUG - 24 1973, by L.E. GOULD