


T.18S.,R.45E.,W.M.

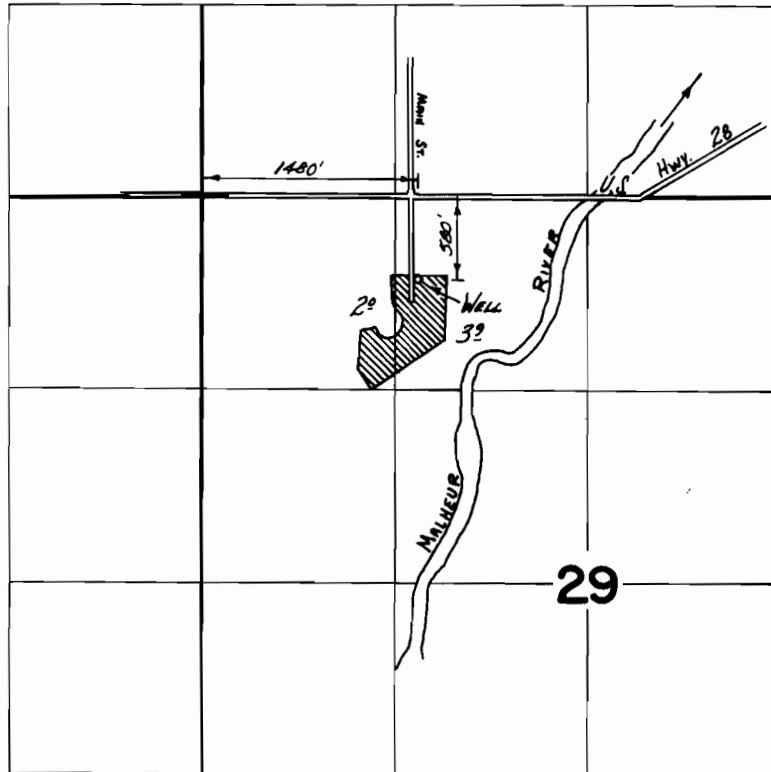

**FINAL PROOF SURVEY**  
UNDER

Application No. G-4679 Permit No. G-4406  
IN NAME OF

CITY OF VALE

Surveyed May 22 1973, by D. Noray