


T.15S.,R.46E.,W.M.

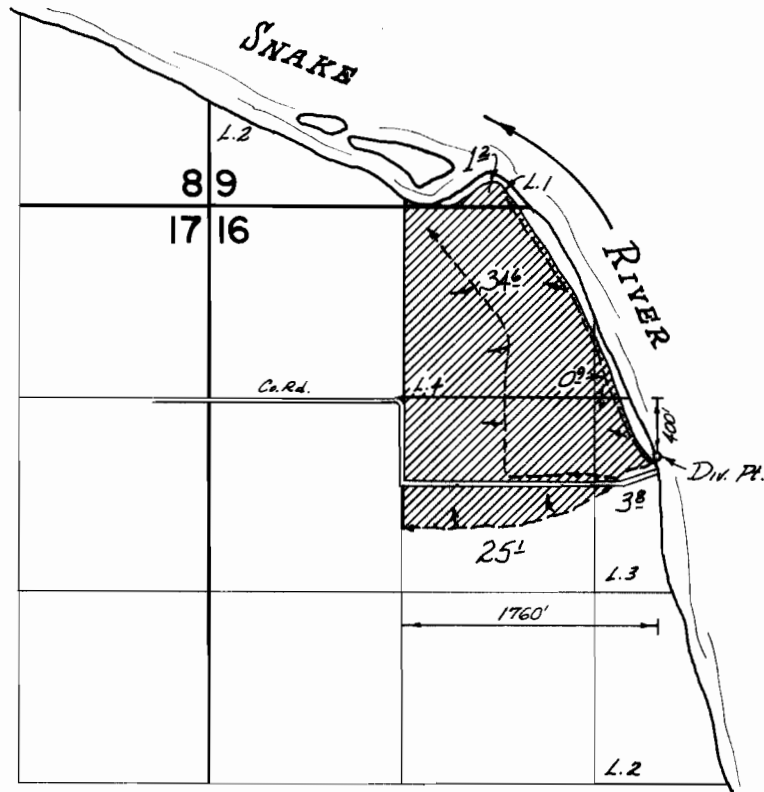

FINAL PROOF SURVEY
UNDER

Application No. 39420 Permit No. 29608
IN NAME OF

MARJORIE STREAM

Surveyed May 26 1973, by D. NORBY