



T.16&17S, R.47E., W.M.

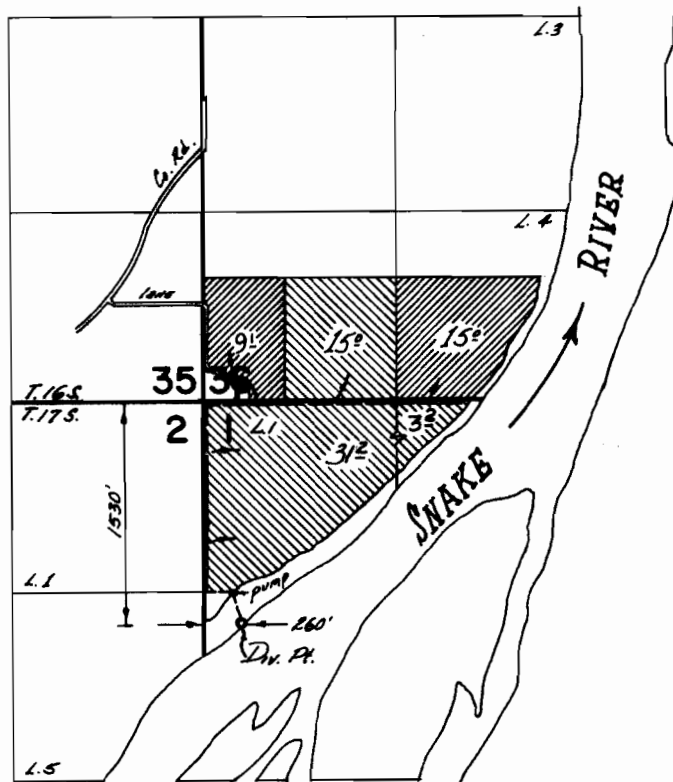

 Primary
 Supplemental

FINAL PROOF SURVEY UNDER

Application No. 41005 Permit No. 30573
IN NAME OF

THOMAS A. BURNS

Surveyed May 20 1973, by D. NORBY