


T.16S.,R.47E.,W.M.

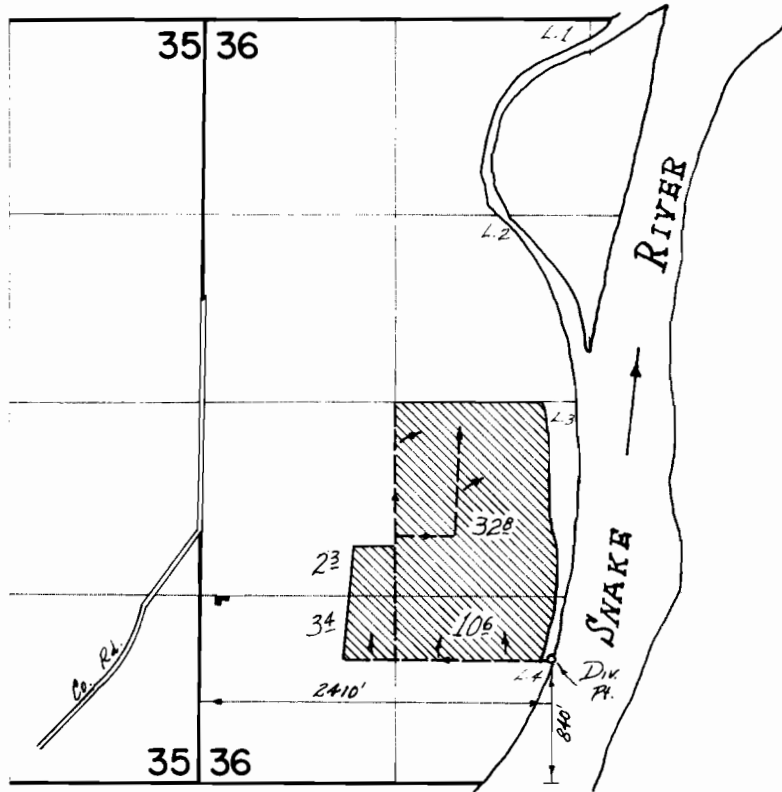

FINAL PROOF SURVEY
UNDER

Application No. 41912 Permit No. 31523
IN NAME OF

EARL T. BROWN

Surveyed May 26 1973, by D. Norey