


T.17S.,R.47E.,W.M.

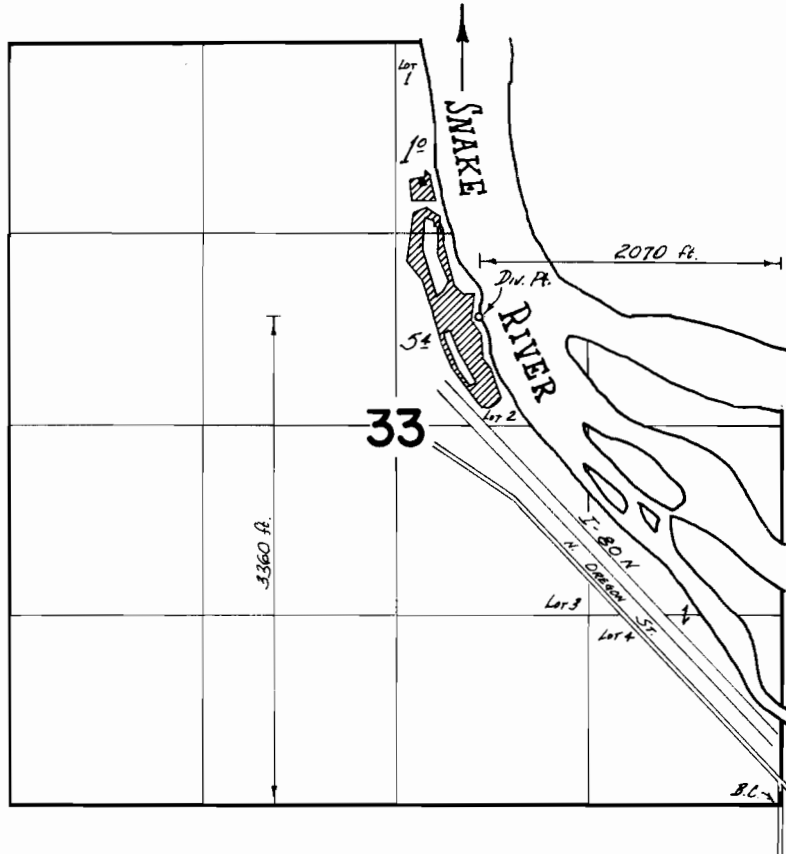

FINAL PROOF SURVEY
UNDER

Application No. 42959 Permit No. 32094
IN NAME OF

STATE PARKS & RECREATION DIVISION (Q.S.H.D.)

Surveyed MAY 28 1973, by D. NORBY