


T.18S.,R.45E.,W.M.

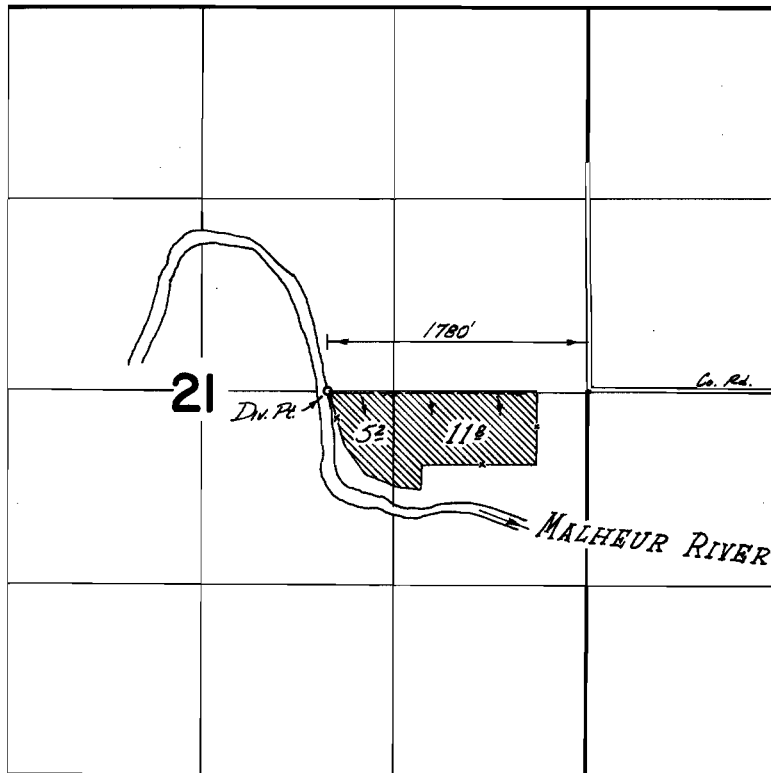

FINAL PROOF SURVEY
UNDER

Application No. 44492 Permit No. 33299
IN NAME OF

CLAUDE SHEARER

Surveyed May 25 1973, by D. Nobby