


T.15S.,R.46E.,W.M.

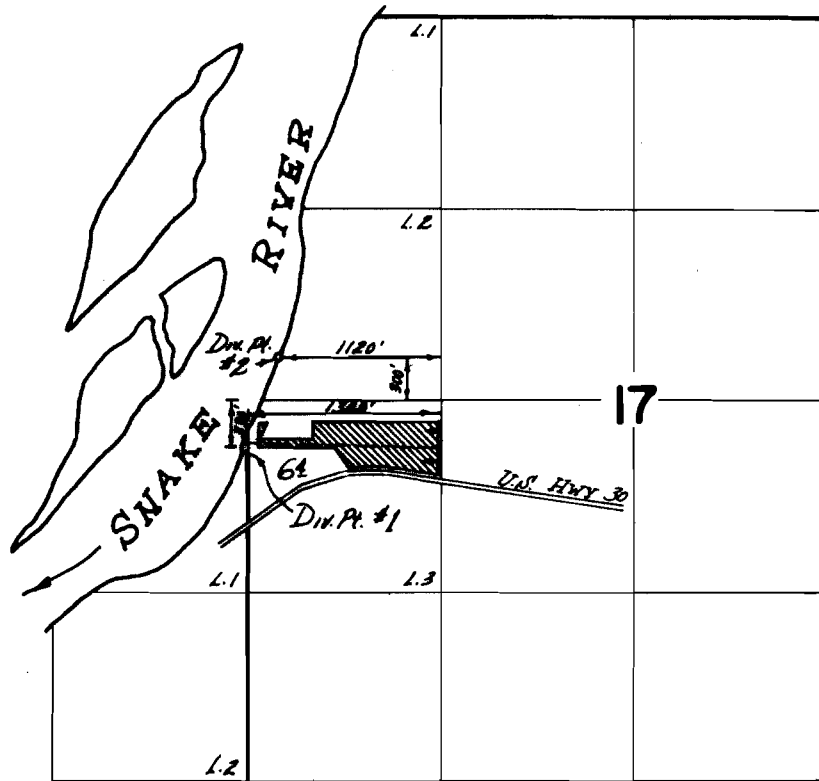

**FINAL PROOF SURVEY**  
UNDER

Application No. 45430 Permit No. 33908  
IN NAME OF

CARL Q. & DORIS V. GROOMS

Surveyed May 26 1973, by D. NORBY