


T.6S. R.1&2W. W.M.

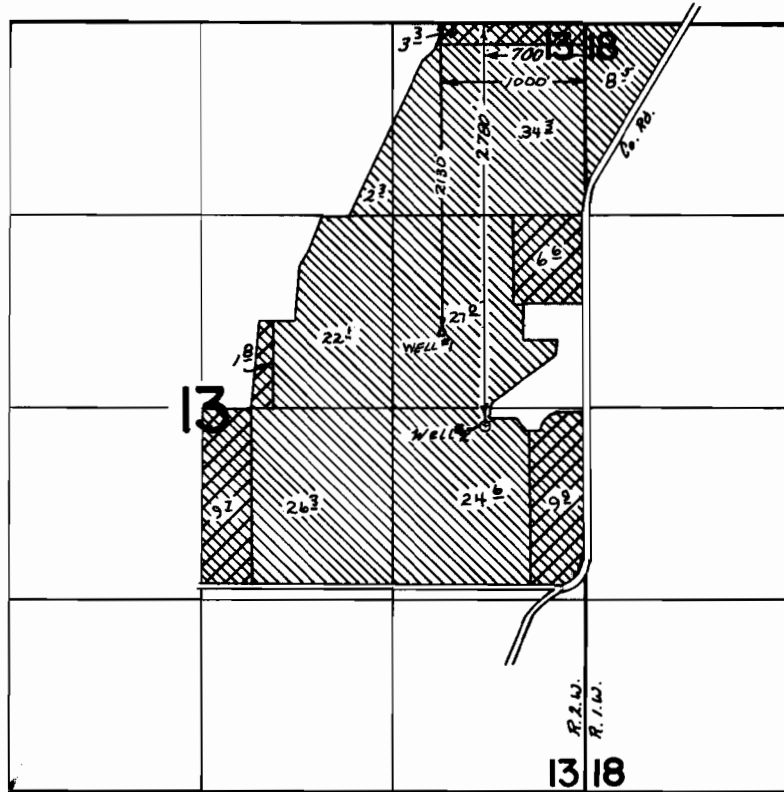

FINAL PROOF SURVEY
UNDER

Application No. G-6477 Permit No. G-6100
G-4619 E-4345
IN NAME OF



THOMAS E. HYNES

Surveyed Oct. 4 1972, by R. B. Mucken
MAY 18, 1976 L. Toll