


6-3048

41143

T.6N. R.35E. W.M.

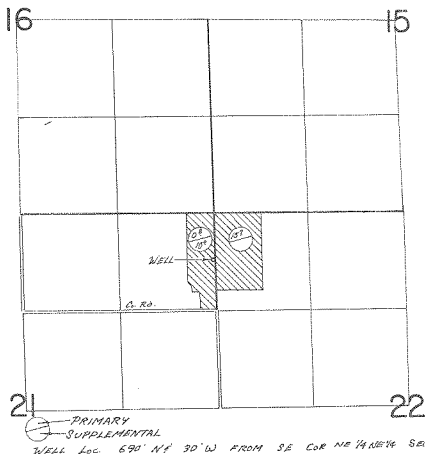

FINAL PROOF SURVEY UNDER

Application No. 6-2242 Permit No. 6-2048
IN NAME OF

R. G. RENCKEN

Surveyed April 19, 1922, by R. G. MUCKEN