


6-4091

41149

T.6N. R.35E. W.M.

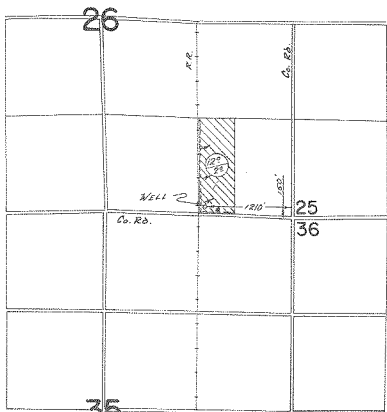

SUPPLEMENTAL
PRIMARY

FINAL PROOF SURVEY
UNDER

Application No. 6-4312 Permit No. 6-4091

IN NAME OF

AARON J. WEIS

Surveyed APRIL 17, 1973, by R. G. MUCKEN