


G-4220  
41150

T.4N. R.29E. W.M.

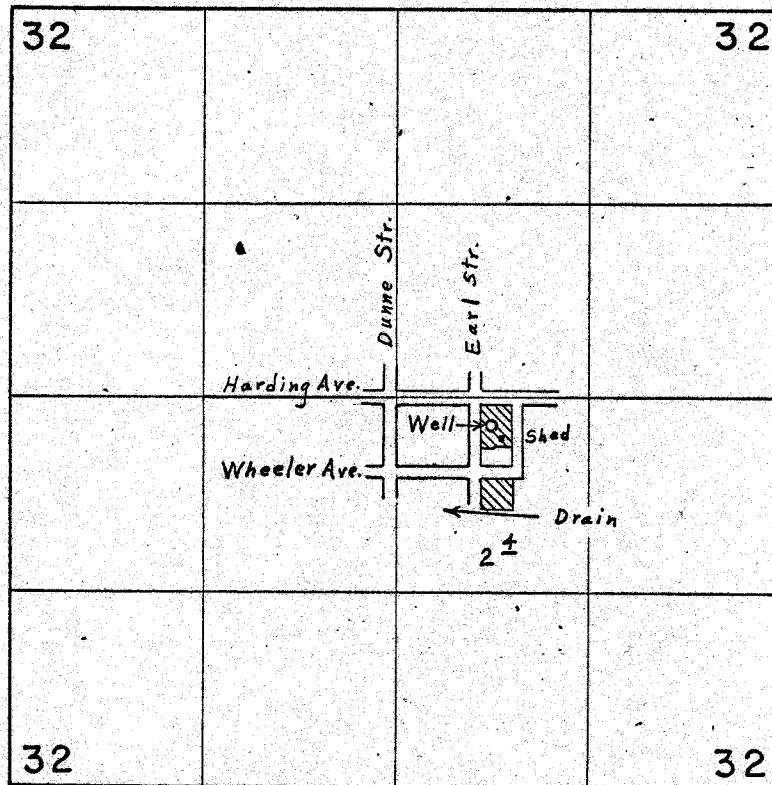

Well located 190' S. & 650' E. from Center Sec. 32

**FINAL PROOF SURVEY**  
UNDER

Application No. G-4478 Permit No. G-4220  
IN NAME OF  
**SHIRLEY DAGGETT**

Surveyed April 12, 1973, by L. E. Gould