


T.4N. R.28E. W.M.

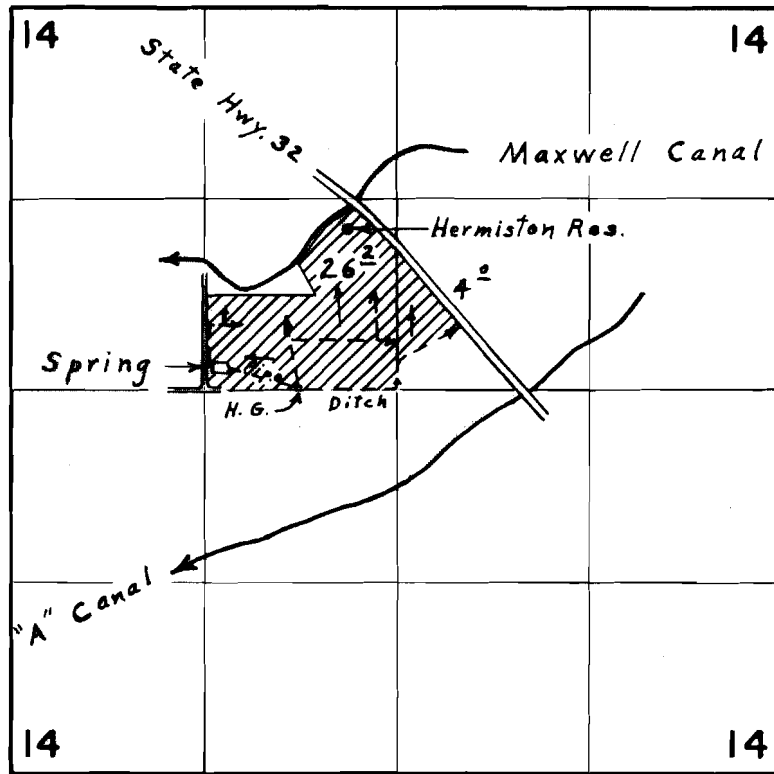

Spr. located 150' N. & 120' E. from S.W. Cor. S.E. $\frac{1}{4}$ N.W. $\frac{1}{4}$ Sec. 14

FINAL PROOF SURVEY
UNDER

Application No. 41950 Permit No. 31463
IN NAME OF
TOM KOSMOS

Surveyed April 14, 1973, by L. E. Gould