


T.2N.R.34E.W.M.

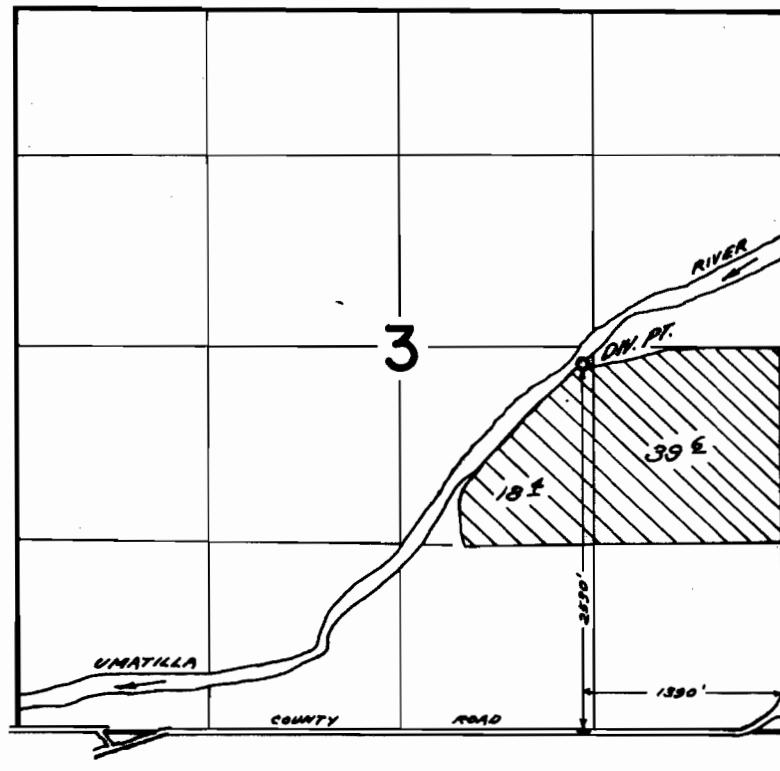

**FINAL PROOF SURVEY**  
UNDER

Application No. 43349 Permit No. 32400  
IN NAME OF

WALTER H. AND BERYL B. RONDE

Surveyed APR. 19 1973, by D. M. NORBY