


T.1S. R.38E. W.M.

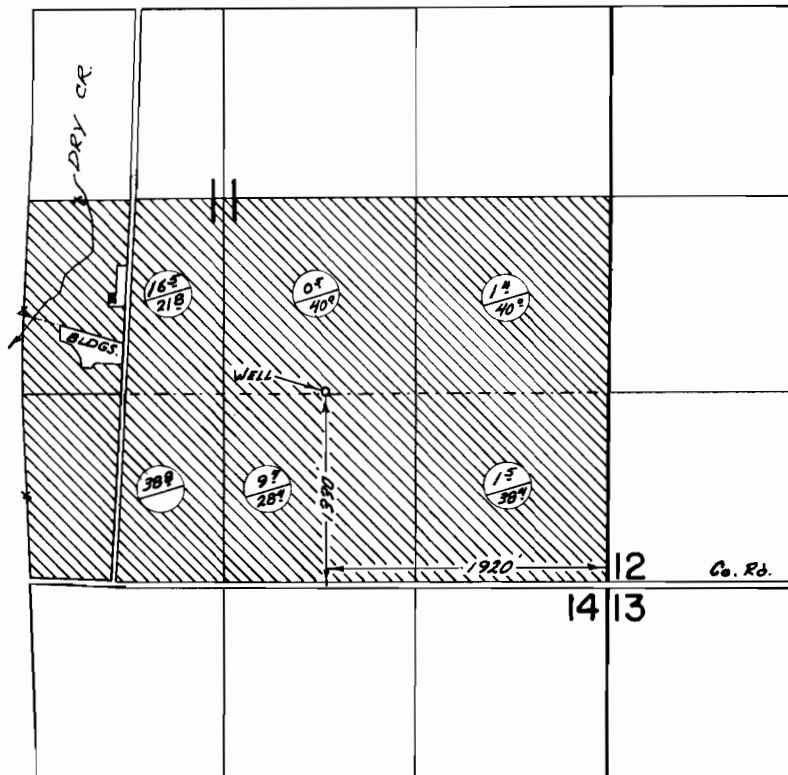

PRIMARY
SUPPLEMENTAL

FINAL PROOF SURVEY
UNDER

Application No. G-3420 Permit No. G-3206
IN NAME OF

L. R. STARR

Surveyed JULY 13 1973, by R. G. MUCKEN