


T.2S.R.38E.W.M.

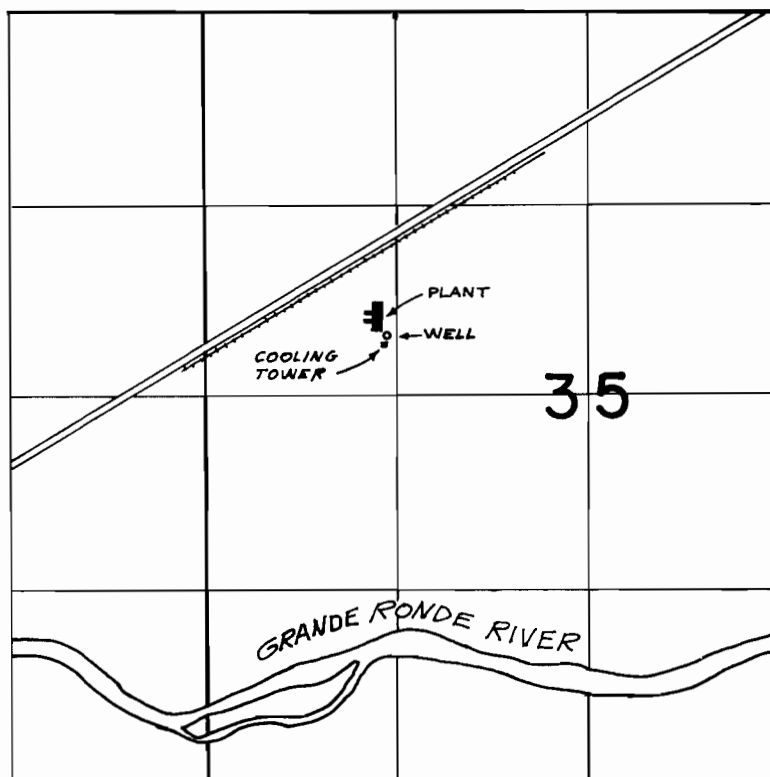

WELL - 425' N., 1250' E. FROM WEST 1/4 COR. SEC. 35

FINAL PROOF SURVEY
UNDER

Application No. G-3529 Permit No. G-3321
IN NAME OF

BORDEN CHEMICAL COMPANY

Surveyed July 16 1973, by R. MUCKEN