


T.2S. R.38E. W.M.

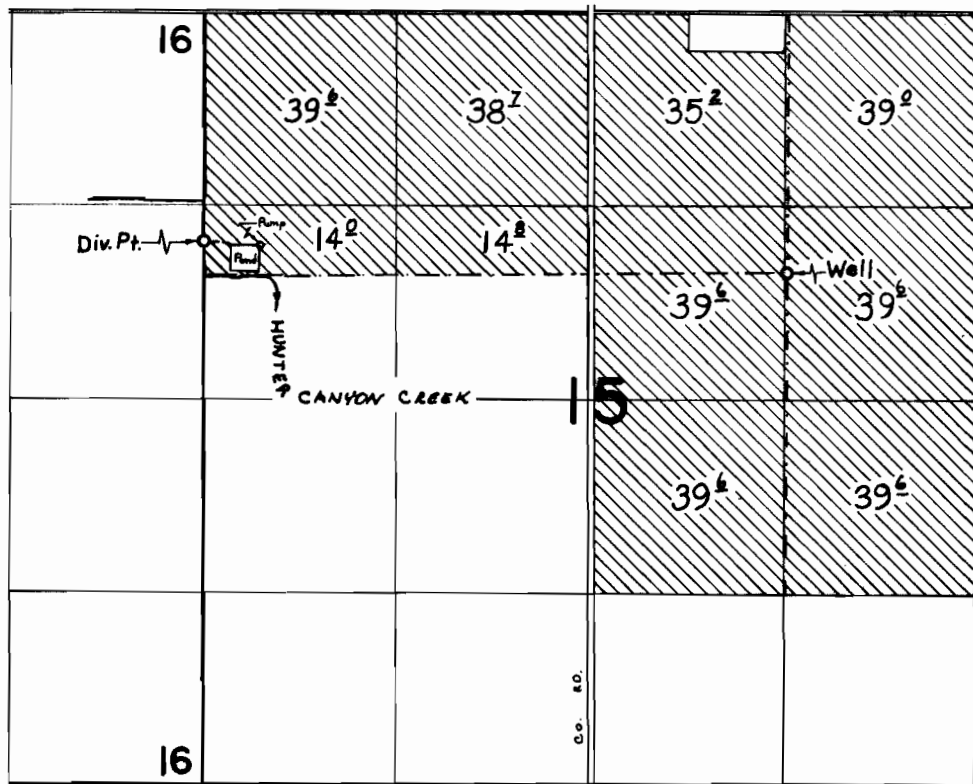

Div. Pt. Loc: 1580' S. from NW. corner Section 15
 Well Loc: 1790' S. & 1310' W. from NE. corner Section 15

FINAL PROOF SURVEY UNDER

Application No. 42298 G-3680 Permit No. 31964 G-3486
 IN NAME OF

RONALD WILFORD & CAROL B. WESTENSKOW

Surveyed JULY 10, 1973, by R. G. MUCKEN