


T.1S. R.38E. W.M.

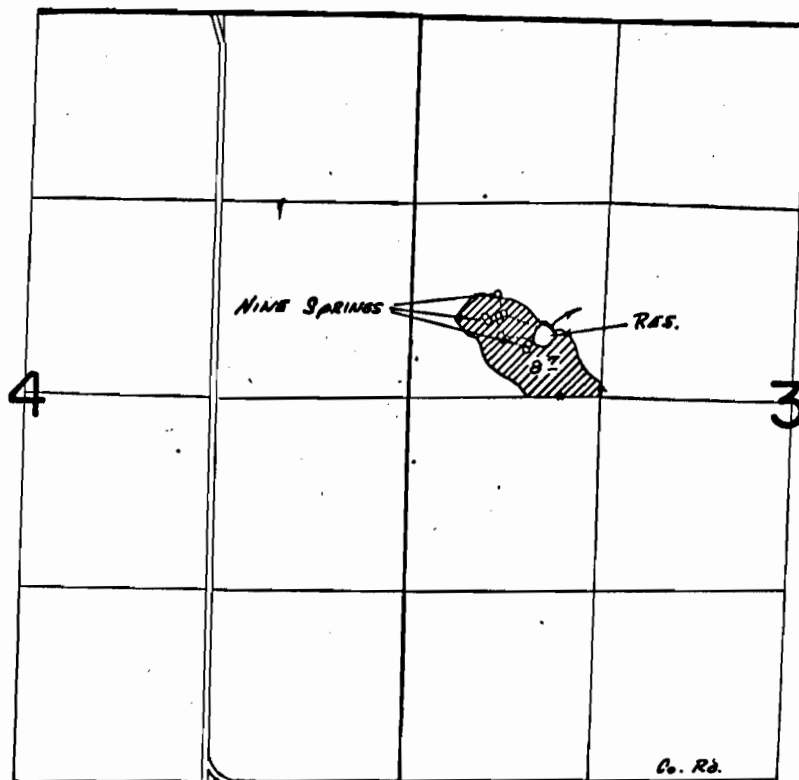

SPRINGS LOC. : 700' N + 610' E ; 560' N + 650' E ; 550' N + 620' E ;
550' N + 540' E ; 520' N + 630' E ; 620' N + 530' E ;
420' N + 640' E ; 360' N + 830' E ; 330' N + 800' E
R.R. LOC. : 450' N + 1000' E ALL FROM W 1/4 COR SEC 9

FINAL PROOF SURVEY
UNDER

Application No. R-44942 Permit No. R-5068
44049 92860
IN NAME OF

FLOYD A. FEIK

Surveyed JULY 11 1959, by R. G. Mucken