


T.1S. R.38E. W.M.

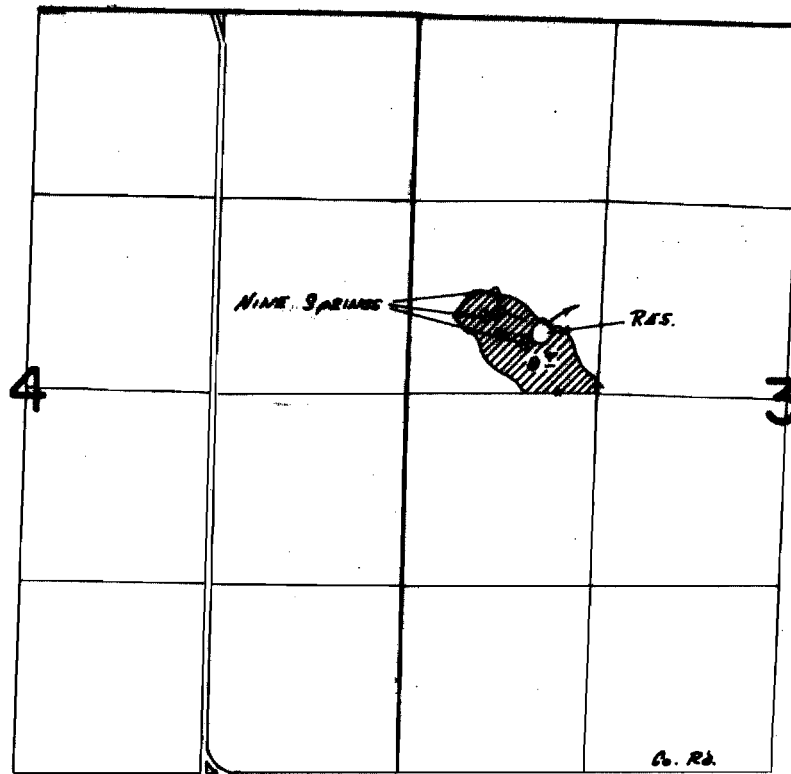

SPRINGS Loc. : 700' N + 600' E ; 560' N + 650' E ; 550' N + 620' E ;  
530' N + 590' E ; 520' N + 630' E ; 520' N + 550' E ;  
420' N + 640' E ; 360' N + 830' E ; 390' N + 800' E  
RES. Loc. : 450' N + 1000' E ALL FROM WM COR SEC 3


**FINAL PROOF SURVEY**  
UNDER

R-44302 R-5067  
Application No. 44049 Permit No. 52860  
IN NAME OF

FLOYD A. FEIK

Surveyed July 11 1973, by R. G. Mucken

T.1S. R.38E. W.M.

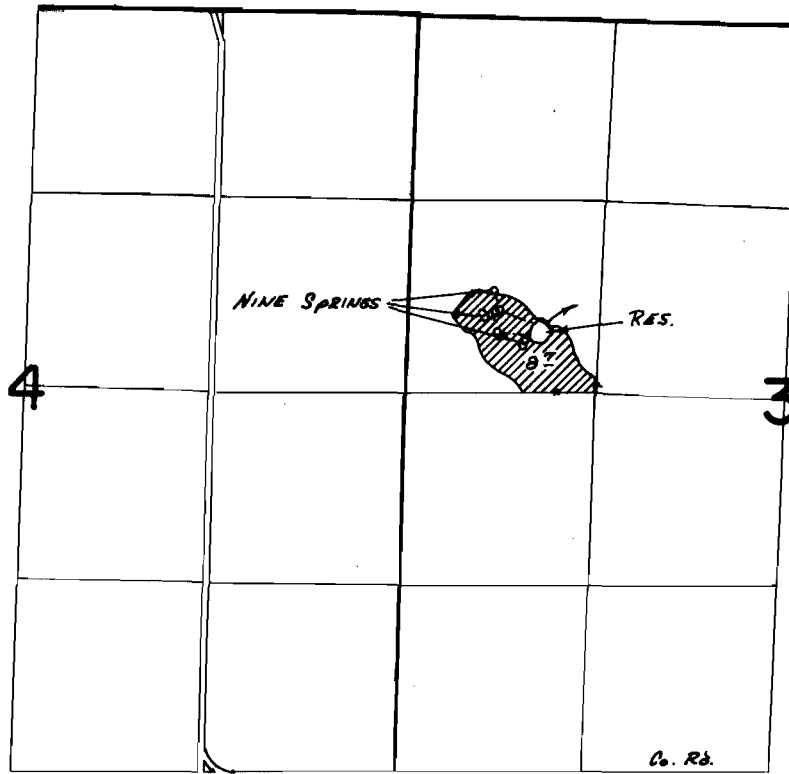

SPRINGS Loc. : 700' N + 610' E ; 560' N + 650' E ; 550' N + 620' E ;  
530' N + 590' E ; 520' N + 630' E ; 520' N + 550' E ;  
420' N + 640' E ; 360' N + 830' E ; 330' N + 800' E  
RES. Loc. : 450' N + 1000' E ALL FROM W/4 COR SEC 9

**FINAL PROOF SURVEY**  
UNDER

R-44342 R-5067  
Application No. 44049 Permit No. 92860  
IN NAME OF

FLOYD A. FEIK

Surveyed July 11, 1959, by R. G. Mucken