


T.2S. R.39E. W.M.

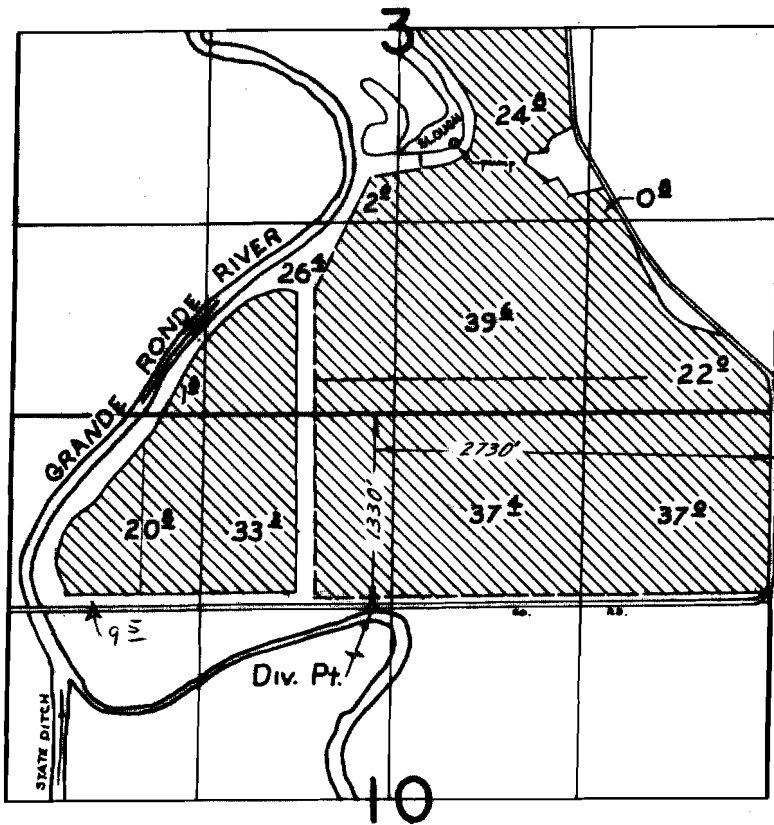

**FINAL PROOF SURVEY**  
UNDER

Application No. 42002 Permit No. 31433  
IN NAME OF

LOREN & MARY FLEET

Surveyed JULY 18, 1973, by R.G. MUCKEN