


T.2S. R.38E. W.M.

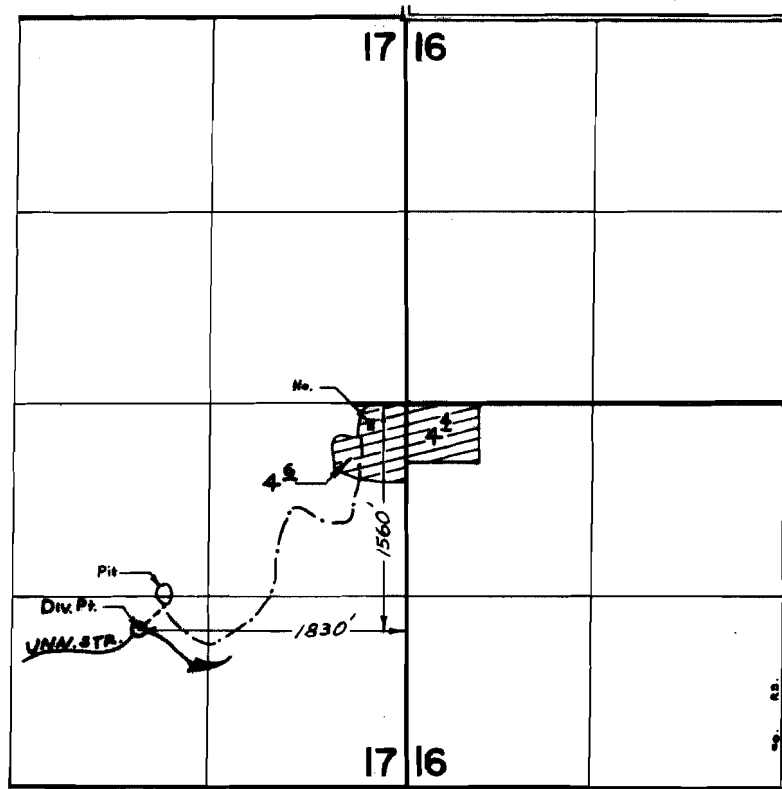

FINAL PROOF SURVEY
UNDER

Application No. 42148 Permit No. 31872
IN NAME OF

RONALD WESTENSKOW

Surveyed JULY 10, 1973, by R. G. MUCKEN