


T.1S. R.38E. W.M.

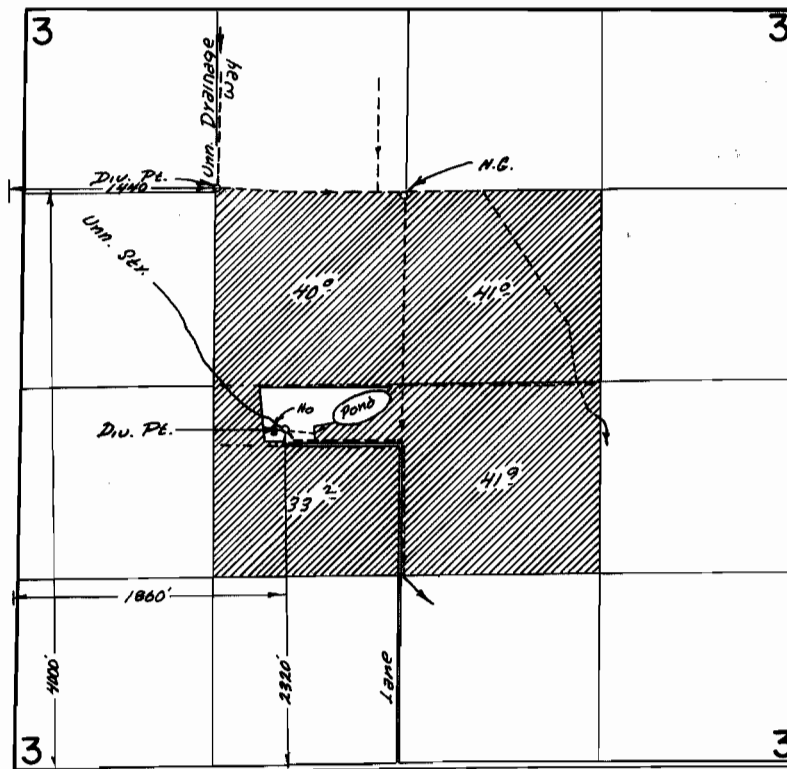

**FINAL PROOF SURVEY**  
UNDER

Application No. 44601 Permit No. 99422  
IN NAME OF

NORMAN WYLAND

Surveyed July 14 1977, by R.B. Mucken