


T.1S. R.38E. W.M.

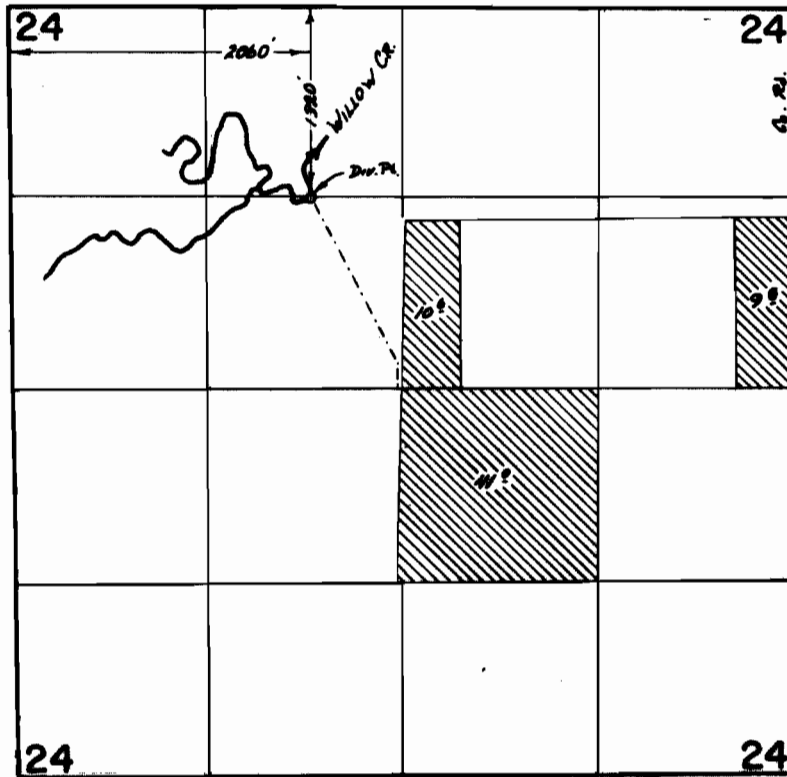

FINAL PROOF SURVEY
UNDER

Application No. 45887 Permit No. 34250
IN NAME OF

ALFRED A. & BONNIE J. ARNOLDUS

Surveyed July 10 1979, by R.G. MUCKEN