


T.1&2N., R.42E., W.M.

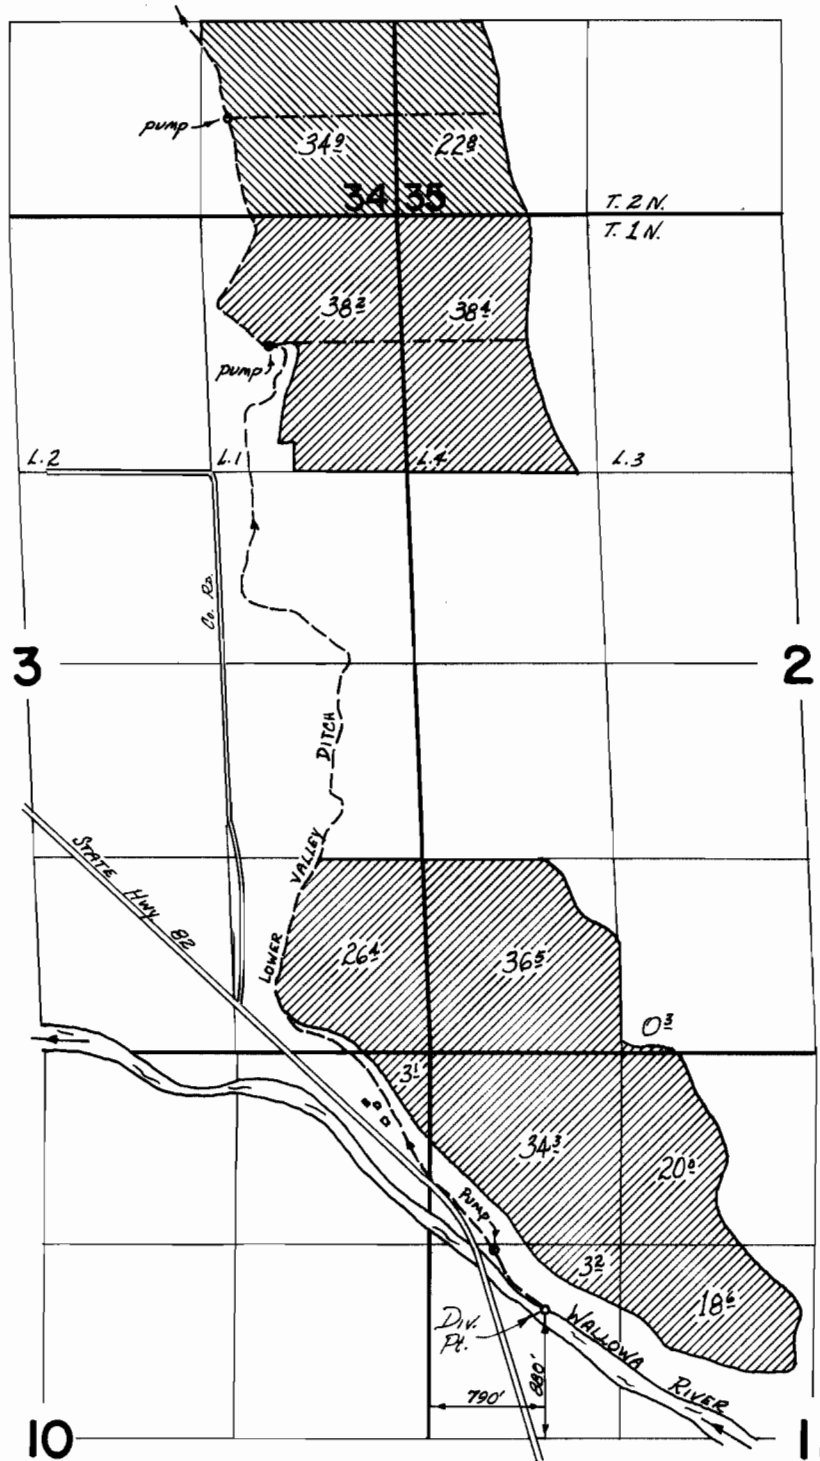

FINAL PROOF SURVEY

UNDER

Application No. 40025 Permit No. 29810
16157 34130

IN NAME OF

WILLIAM M. & MARIE DOUGHERTY

Surveyed Aug. 16 19 73, by D. NORBY