


T. 15., R. 43E., W.M.

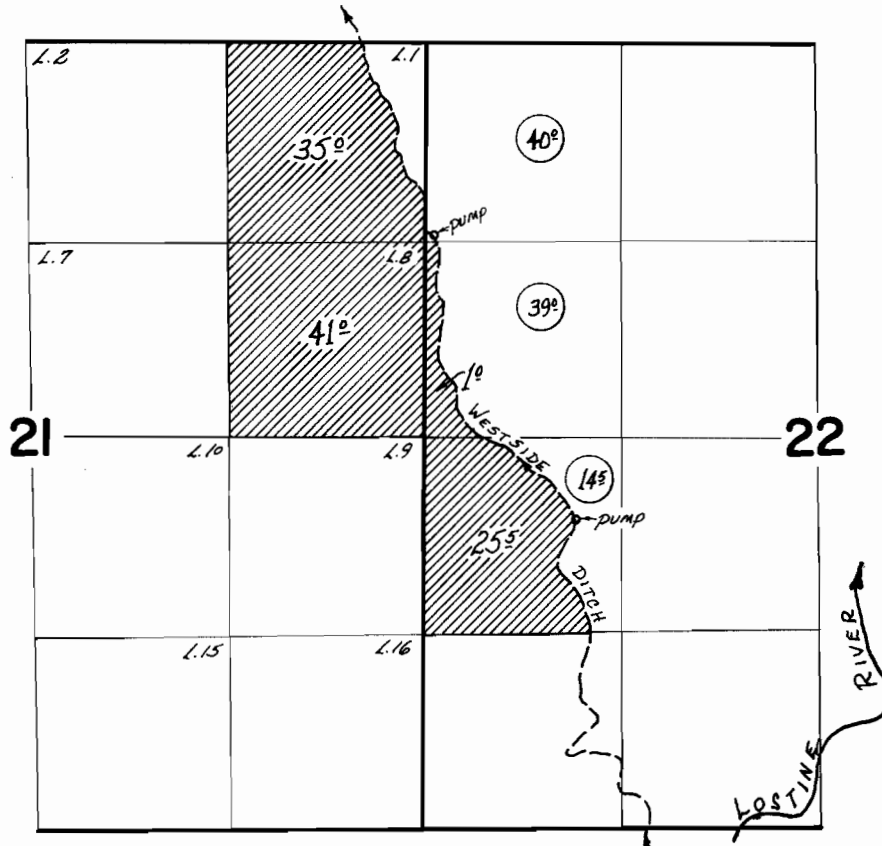

Div. Pt. 100.; 892' S. of 2422' W. FROM SW COR. SEC. 22.

⊙ — CERT. 3180

FINAL PROOF SURVEY
UNDER

Application No. 41628 Permit No. 31199
IN NAME OF

CHARLES F. WYNANS

Surveyed Aug. 10 1973, by D. NORBY