


T.2S.,R.44E.,W.M.

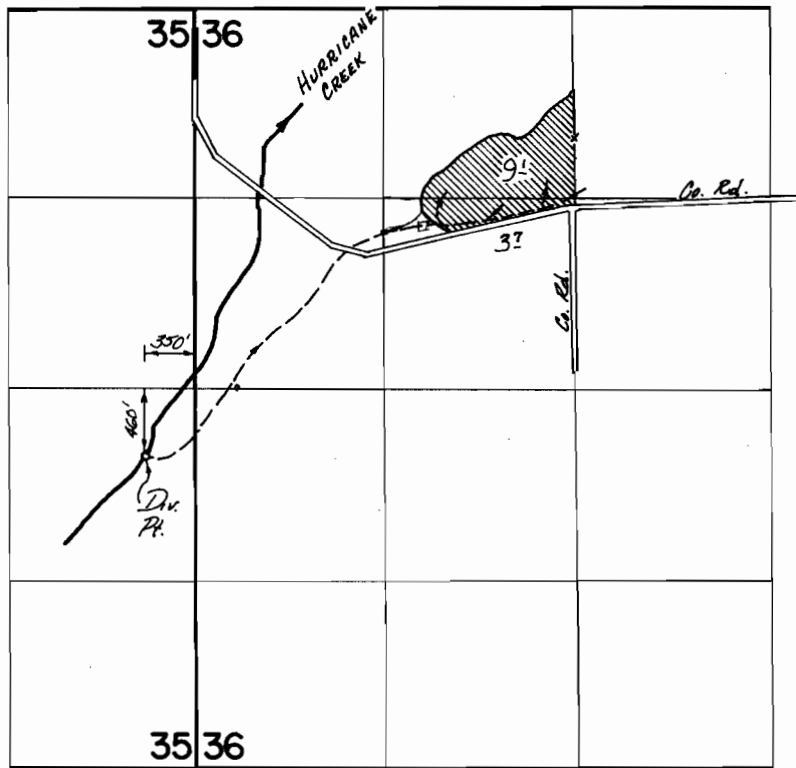

FINAL PROOF SURVEY
UNDER

Application No. 43022 Permit No. 32163
IN NAME OF

GRACE BARTLETT

Surveyed Aug. 8 1973, by D. NORBY