


T.2S.R.45E.W.M.

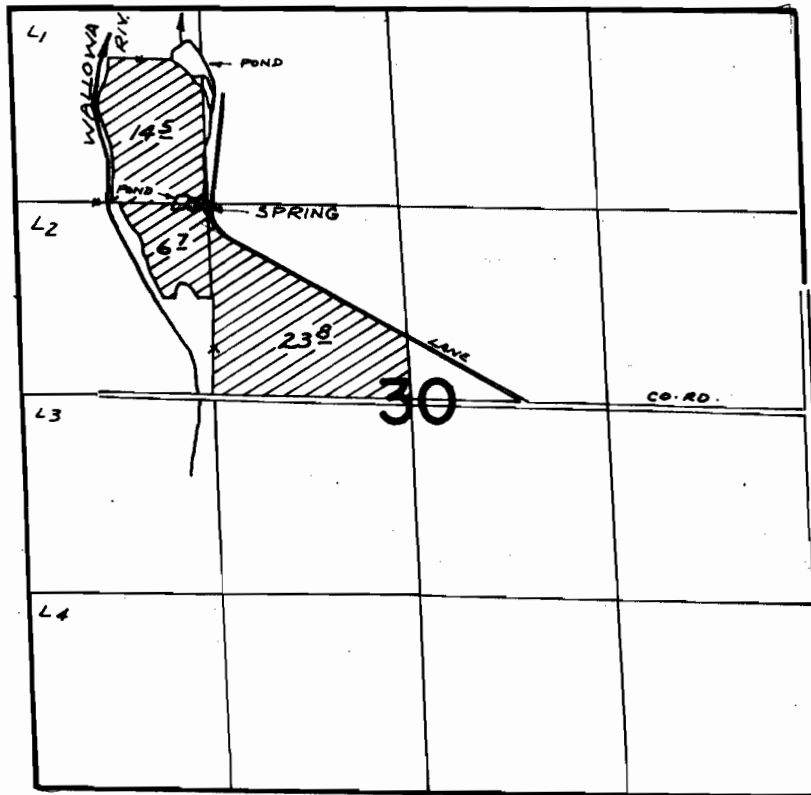

SPRING LOC: 1320' N & 110' W. FROM SE. COR. LOT 2 (SW 1/4 NW 1/4)
SEC. 30

FINAL PROOF SURVEY UNDER

Application No. 43206 Permit No. 32300
IN NAME OF

FRED W. KAUP

Surveyed JULY 31, 1973, by R. MUGGEN