


T.5N.,R.43E.,W.M.

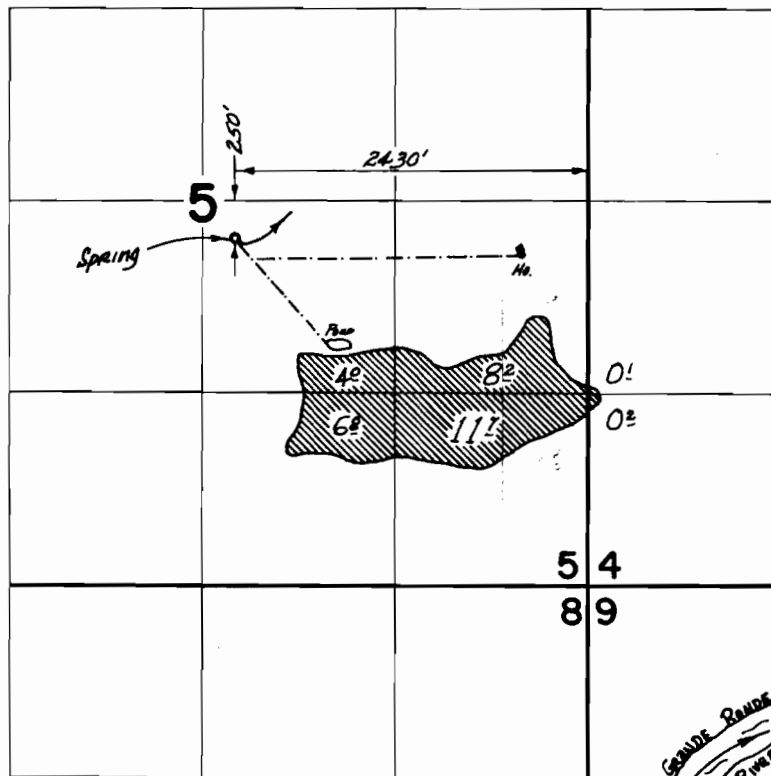

FINAL PROOF SURVEY
UNDER

49144 36333
Application No. 43288 Permit No. 32353
IN NAME OF

E. F. SARGENT

Surveyed Aug. 14, 1973, by D. NORBY