


T.5N., R.43E., W.M.

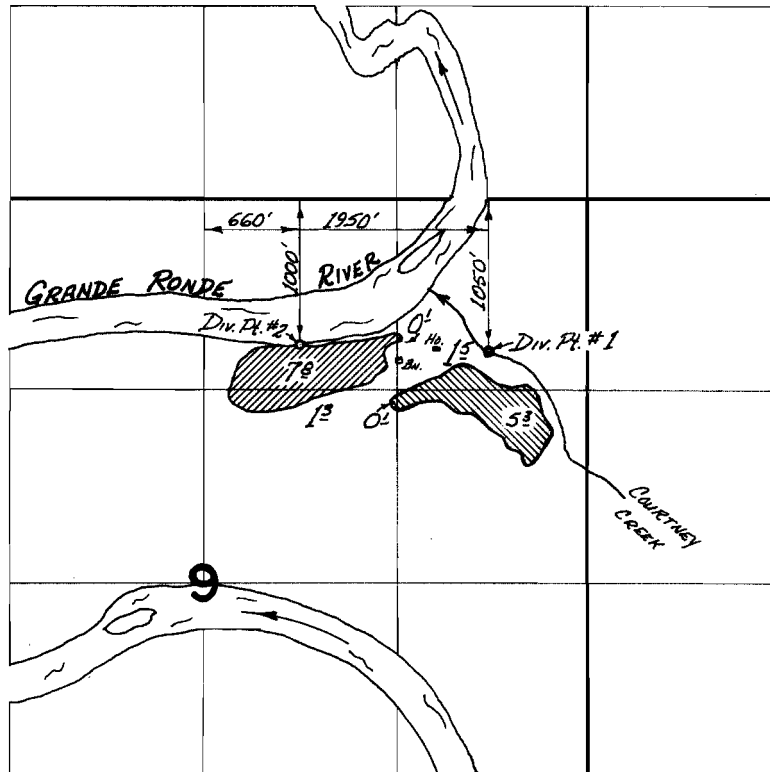

FINAL PROOF SURVEY
UNDER

Application No. 44343 Permit No. 33108
IN NAME OF

HOWARD SALVAGE

Surveyed Aug. 14 1973, by D. Norsey