


T.1S.,R.43E.,W.M.

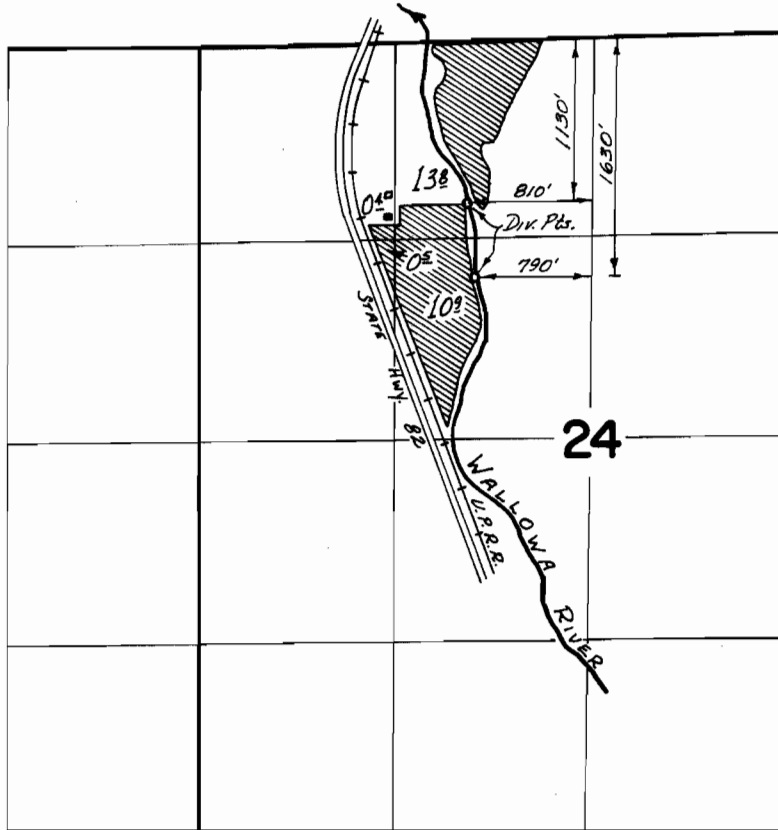

FINAL PROOF SURVEY
UNDER

Application No. 44410 Permit No. 33173
IN NAME OF

ORVAL W. McARTOR

Surveyed Aug. 9 1913, by D. NORBY