


T.5N.,R.43E.,W.M.

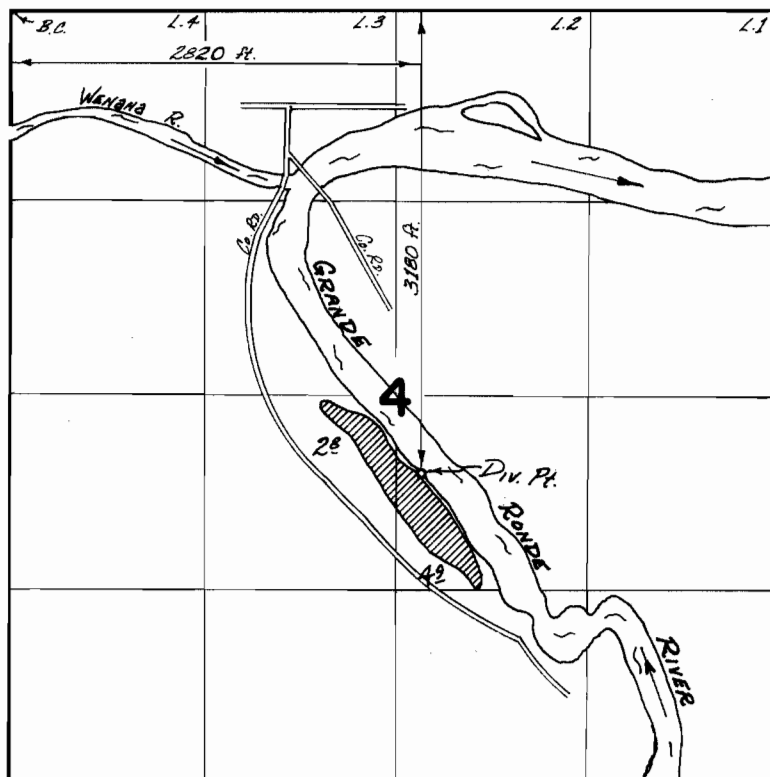

FINAL PROOF SURVEY
UNDER

Application No. 44501 Permit No. 33303
IN NAME OF

DEAN B. ERWIN

Surveyed Aug. 14 19 73, by D. Norby