


T. 15., R. 43E., W.M.

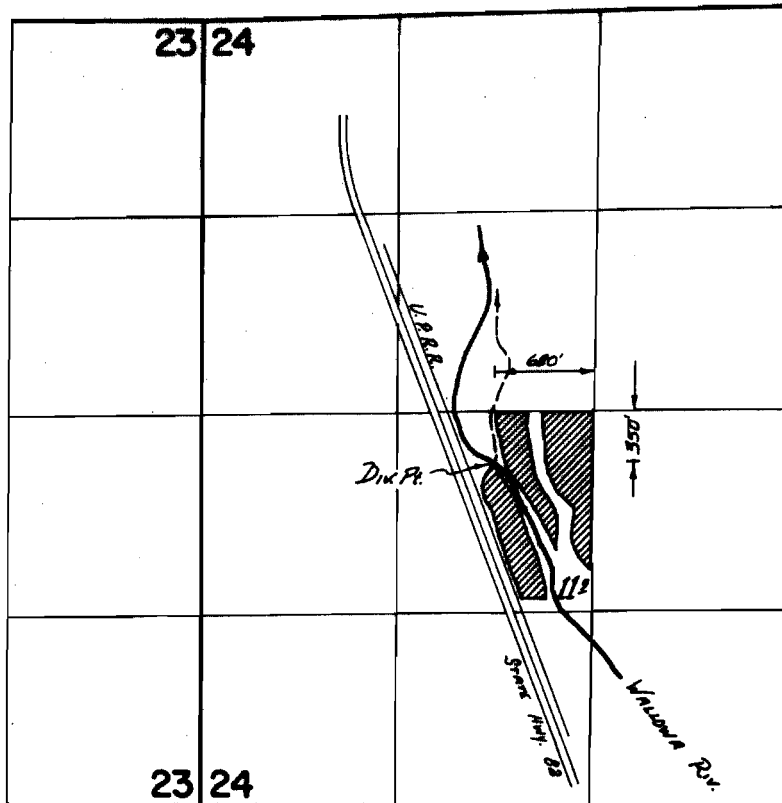

FINAL PROOF SURVEY
UNDER

Application No. 45419 Permit No. 33904
IN NAME OF

GEORGE & DONNA FLOYD

Surveyed Aug. 9 1973, by D. NORBY