


T.5N.,R.43E.,W.M.

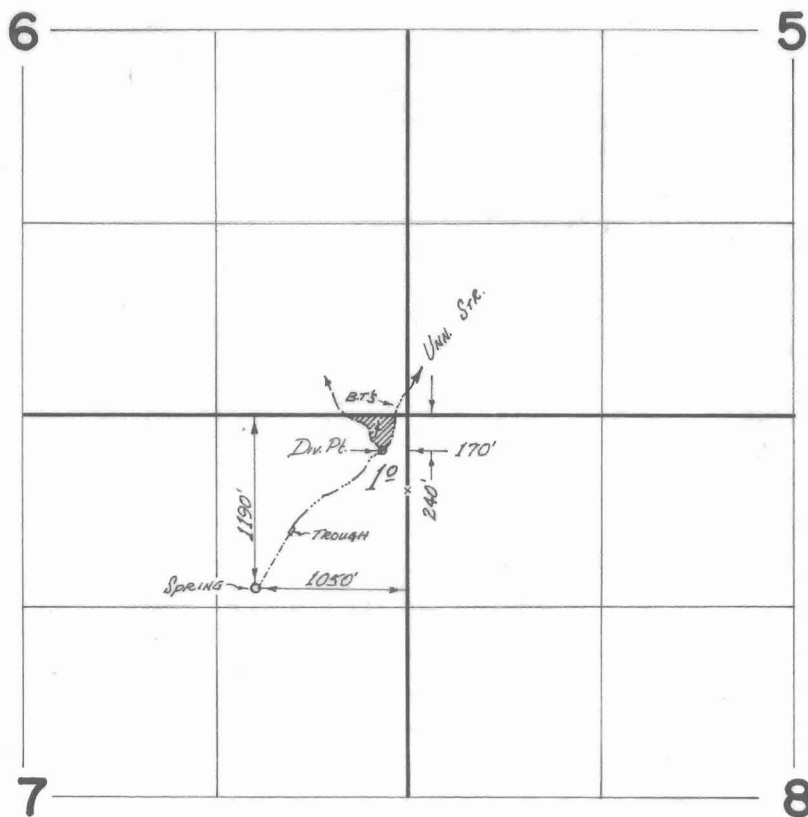

FINAL PROOF SURVEY
UNDER

Application No. 46126 Permit No. 34461
IN NAME OF

OREGON STATE GAME COMMISSION

Surveyed Aug. 14 1973, by D. Norrey