


T.1S., R.43E., W.M.

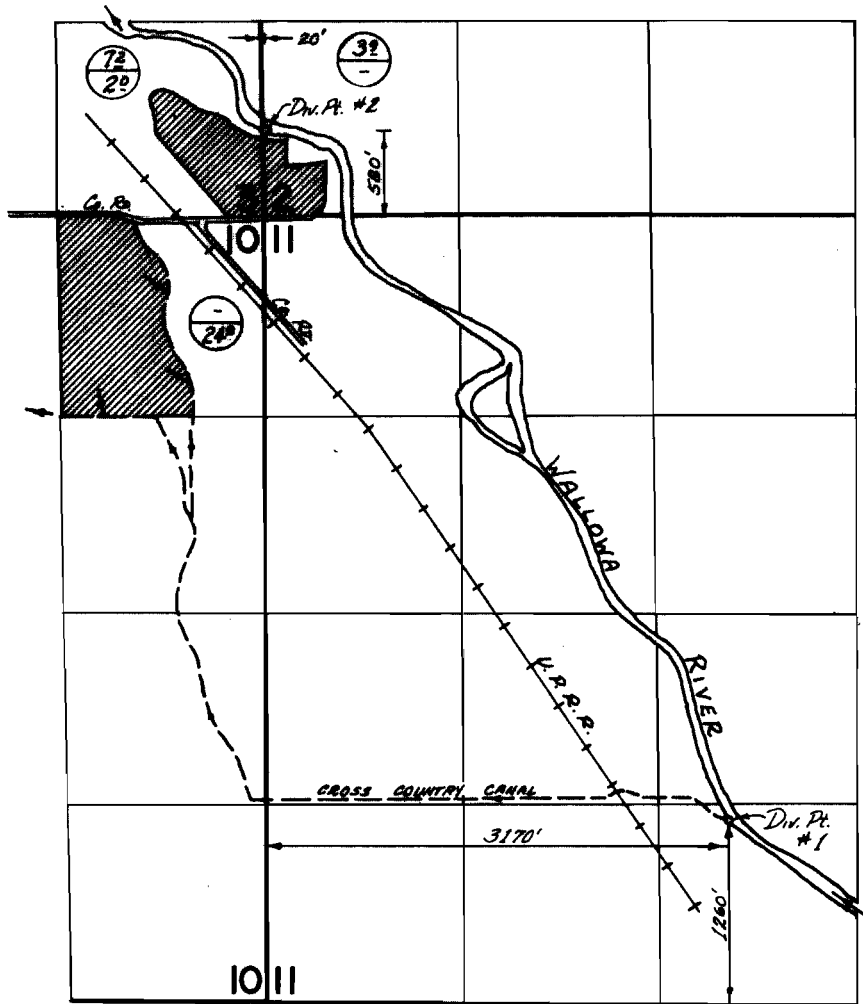

PRIMARY  
SUPPLEMENTAL

**FINAL PROOF SURVEY**  
UNDER

Application No. 46204 Permit No. 34521  
IN NAME OF

W. H. WOOD

Surveyed Aug. 10 1973, by D. NORBY