


T.2N.,R.42E.,W.M.

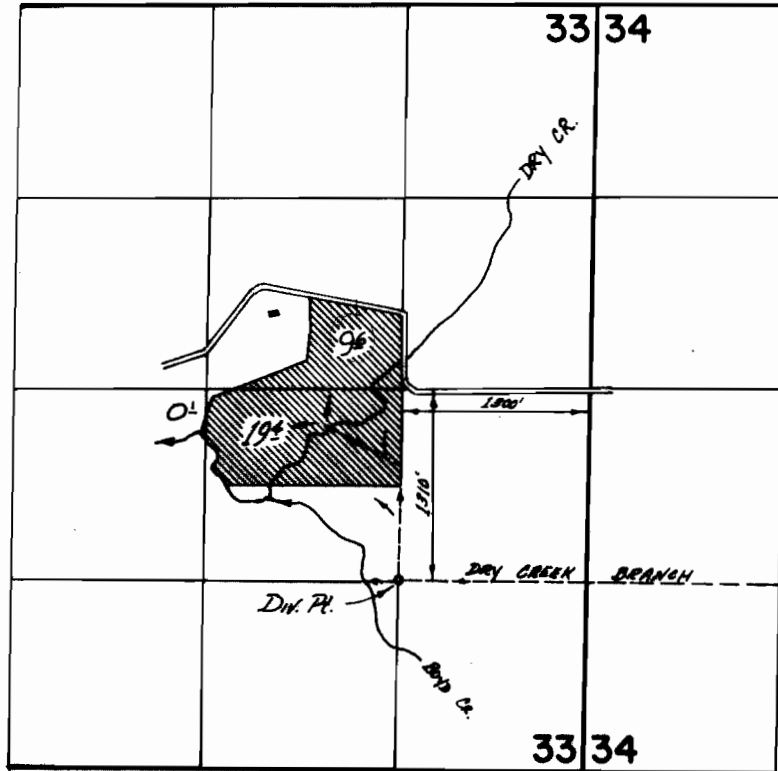

FINAL PROOF SURVEY
UNDER

Application No. 47705 Permit No. 35737
IN NAME OF

ROY M. LEVERENZ

Surveyed Aug. 16 1973, by D. Norrey