


T. 1 S., R. 3 W., W.M.

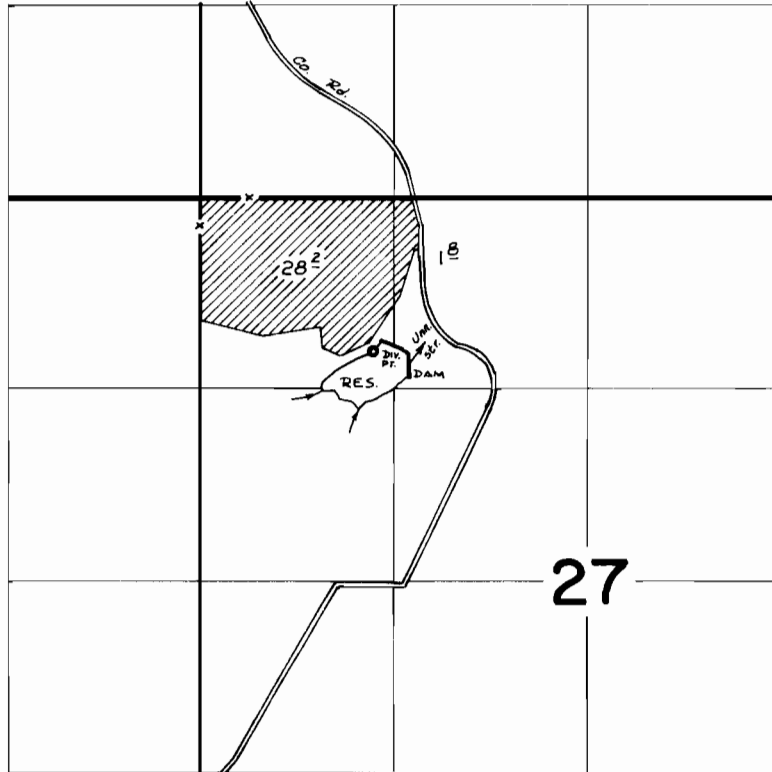

DIV. PT. LOCATED: 1060' S & 1180' E FROM NW COR. SEC. 27. - STREAM
1180' S & 1430' E FROM NW COR. SEC. 27. - RESERVOIR

FINAL PROOF SURVEY UNDER

R-44436

R-5137

Application No. 44302 Permit No. 33132

IN NAME OF

FRANCIS H. HOEFER and CARL A. PIERSON

Surveyed June 13 1972, by D. Norby