


T.2 & 3 S. R.2 W. W.M.

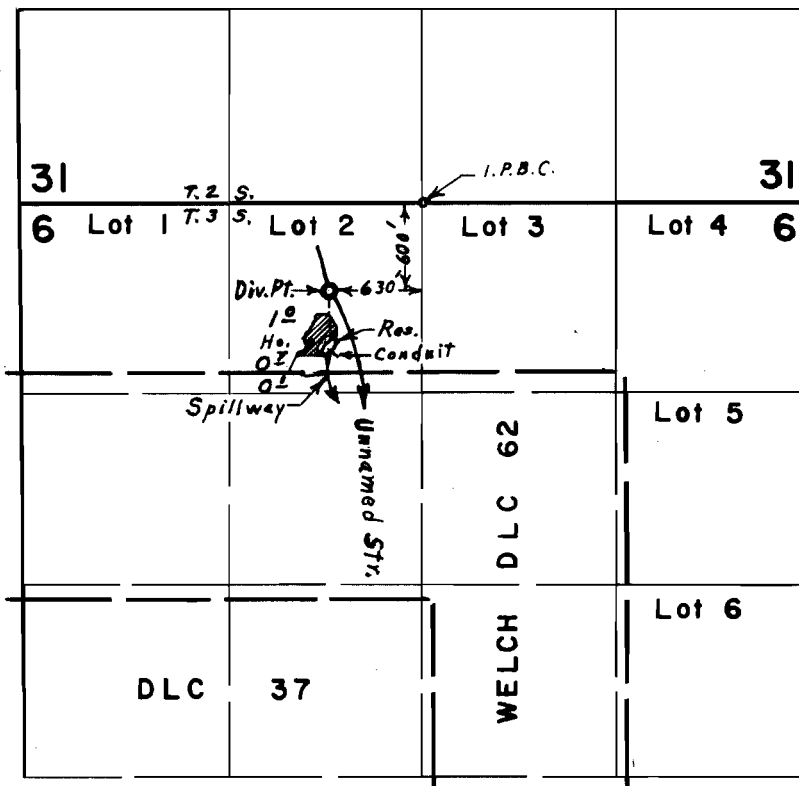

FINAL PROOF SURVEY UNDER

R-45814 R-5398
 Application No. 45483 Permit No. 34022
 IN NAME OF

DONALD W. VERLEY

Surveyed March 27, 1973, by L. E. Gould.