


# T.2 & 3 S. R.2 W. W.M.

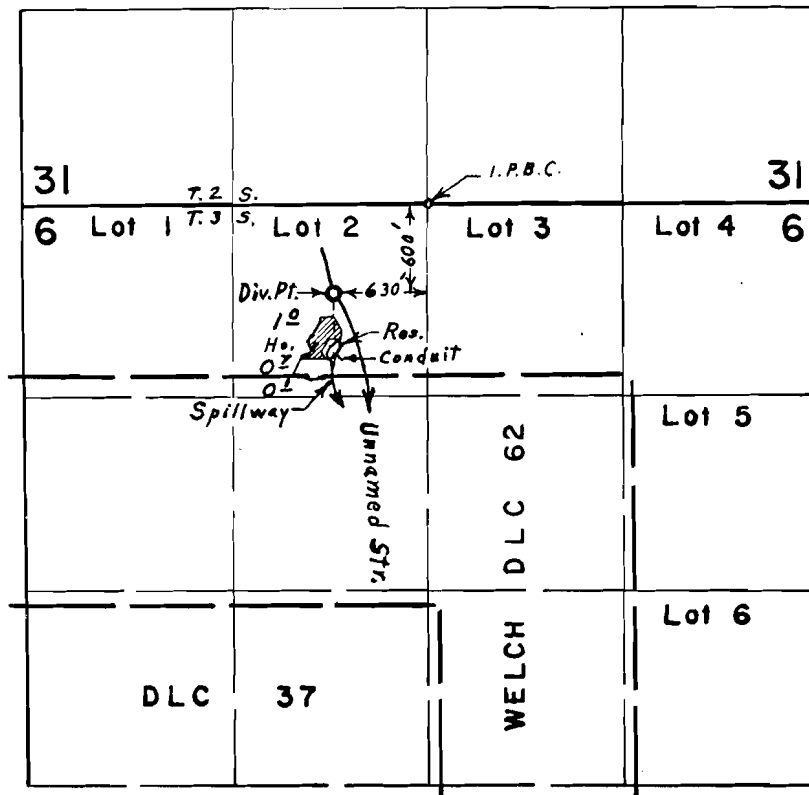

## FINAL PROOF SURVEY UNDER

R-45814 R-5398  
Application No. 45483 Permit No. 34022.  
IN NAME OF

DONALD W. VERLEY

Surveyed March 27, 1973., by L. E. Gould.