


T. 4N. R. 9W. W.M.

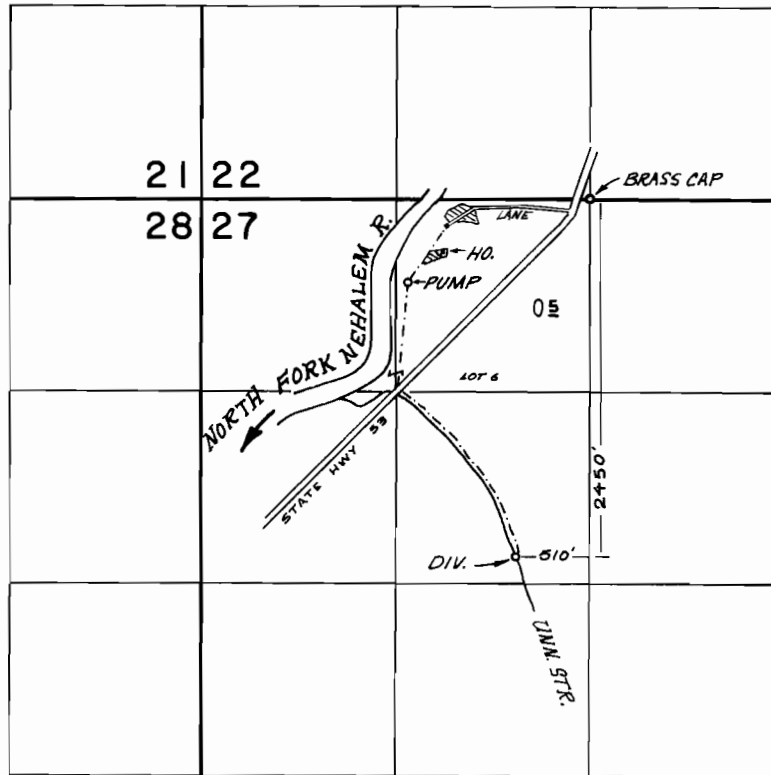

FINAL PROOF SURVEY
UNDER

Application No. 44852 Permit No. 33403
IN NAME OF

HERMAN P. MEIERJURGEN

Surveyed MAY 3 1973, by R. MUCKEN