


T.7 N. R.4 W. W.M.

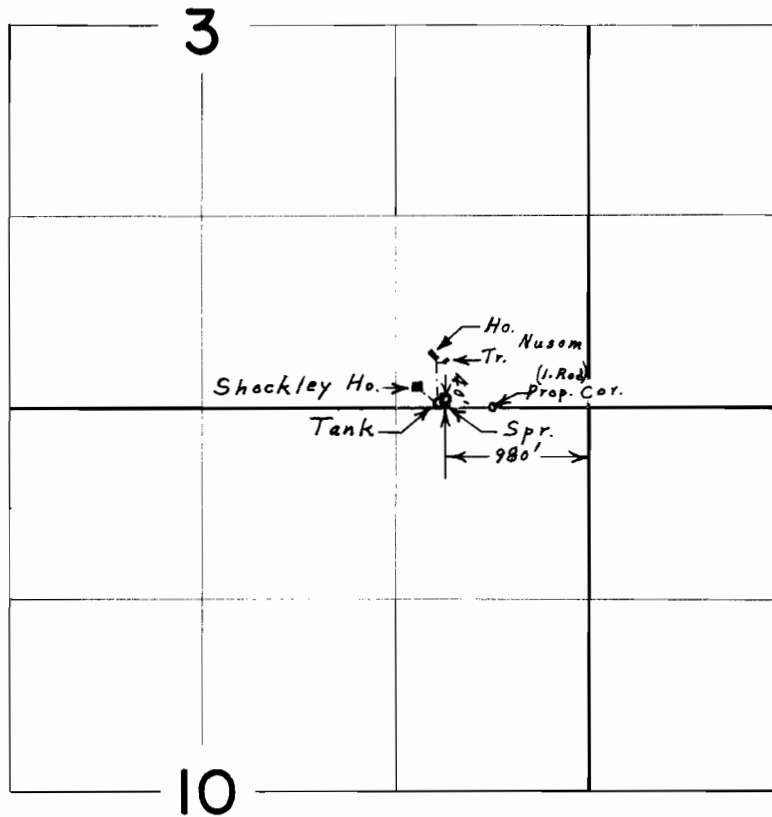

FINAL PROOF SURVEY
UNDER

Application No. 42789. Permit No. 31990...
IN NAME OF

FRANCIS R. NUSOM

Surveyed July 13, 1973, by L. E. Gould.