


T. 7 N. R. 4 W. W. M.

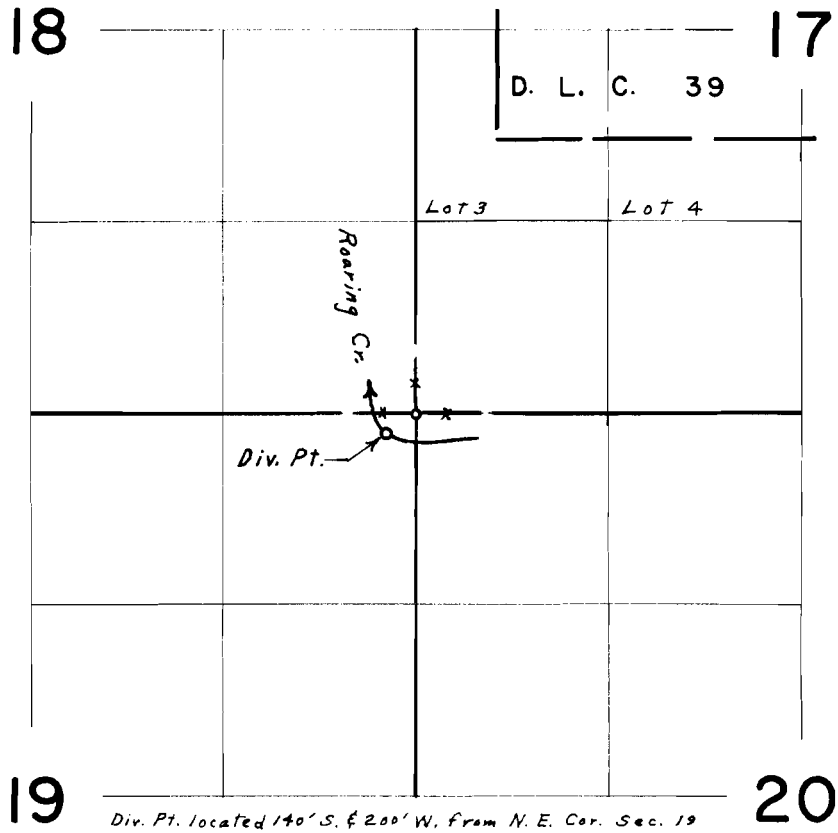

FINAL PROOF SURVEY
UNDER

Application No. 45921 Permit No. 34064
IN NAME OF
CITY OF CLATSKANIE

Surveyed July 9, 1973, by L. E. Gould