


T. 7 N. R. 4 W. W.M.

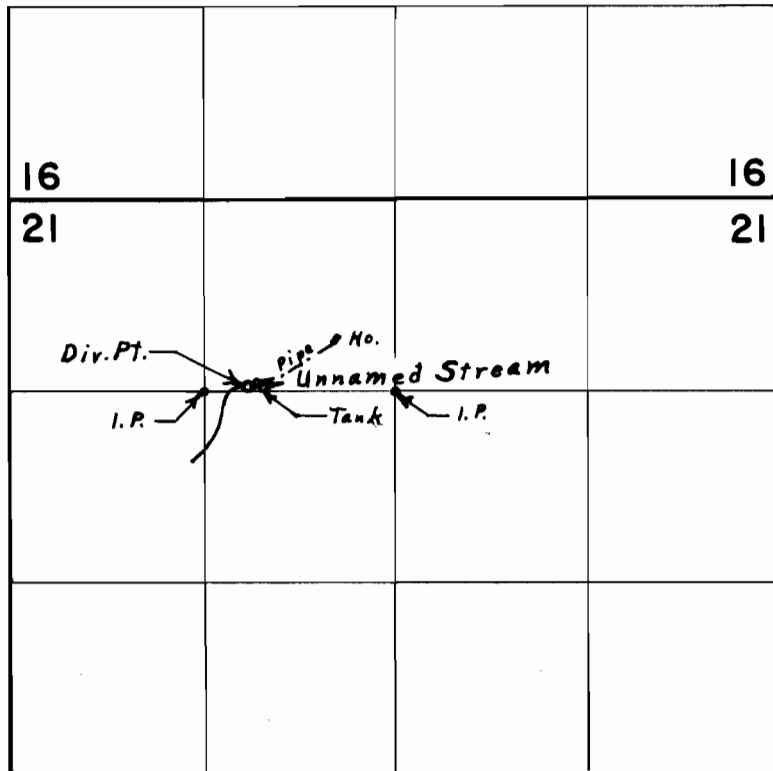

Div. Pt. located: 30' N. & 300' E. from S.W. Cor. N.E. & N.W. Sec. 21

FINAL PROOF SURVEY
UNDER

Application No. 47186 Permit No. 35351
IN NAME OF

GAYLE J, HARDEN

Surveyed July 12, 1973, by L. E. Gould