


T.8 S. R.4 W. W.M.

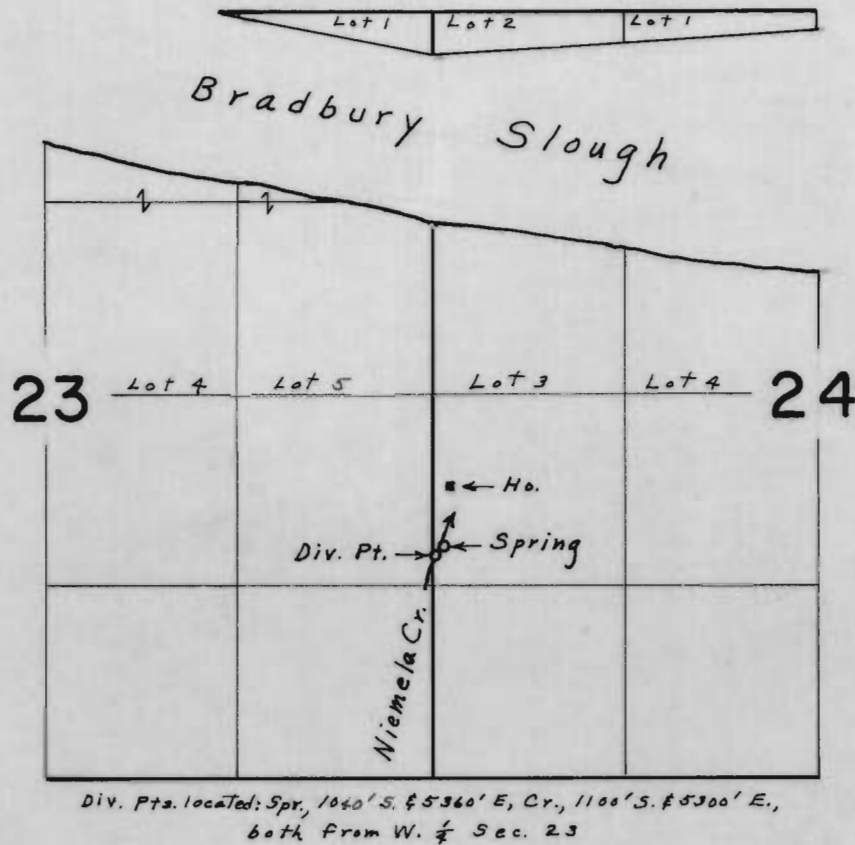

FINAL PROOF SURVEY
UNDER

Application No. 47805 Permit No. 35841
IN NAME OF

ERNEST NIEMELA

Surveyed July 10, 1973, by L. E. Gould