


T.7 N. R.4 W. W.M.

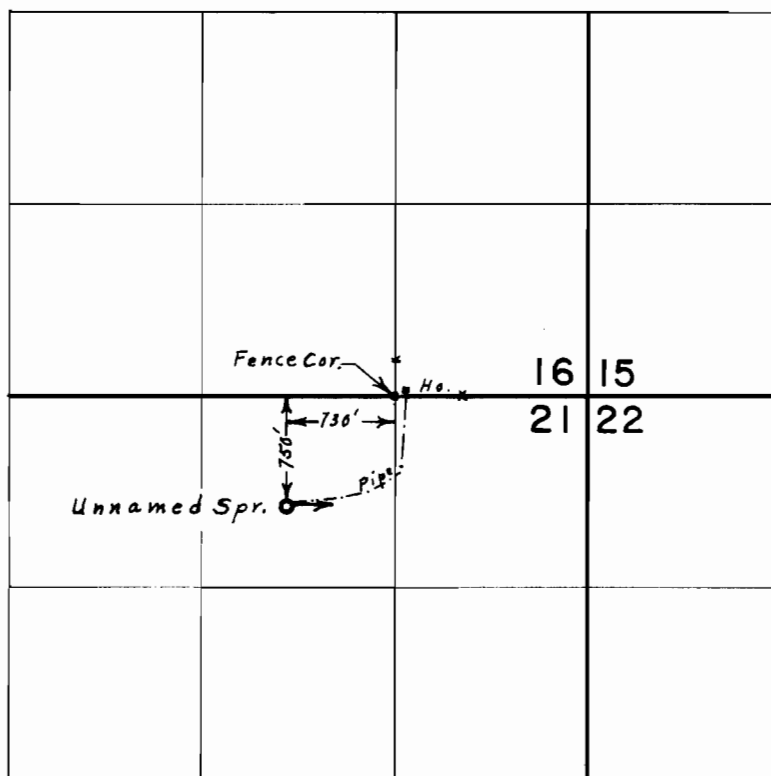

FINAL PROOF SURVEY
UNDER

Application No. 47999 Permit No. 35999
IN NAME OF

M. ESTHER PAYNE

Surveyed July 13, 1973, by L. E. Gould