


T.26S., R.3W., W.M.

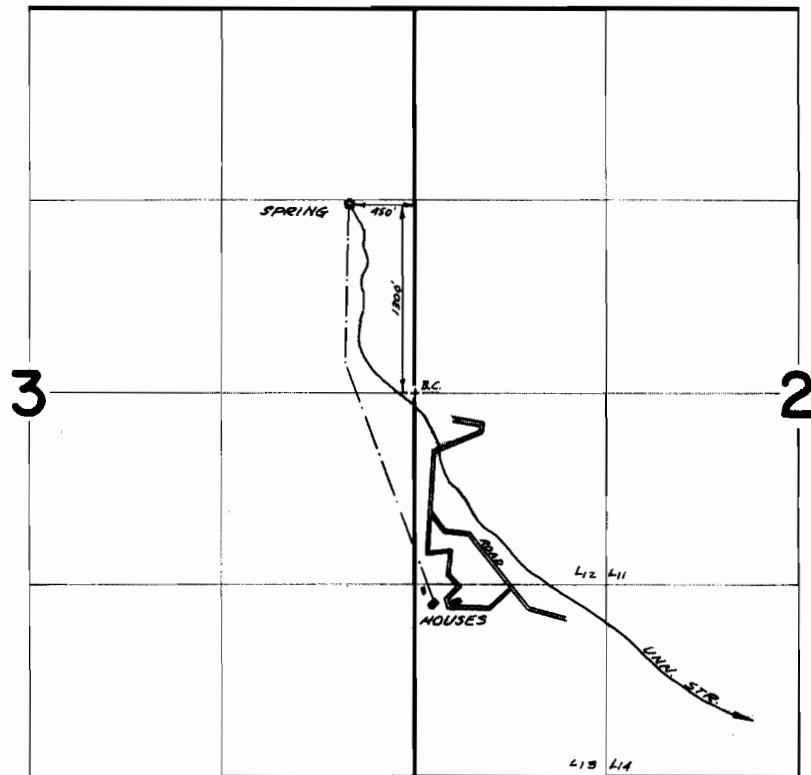

FINAL PROOF SURVEY
UNDER

Application No. 40039 Permit No. 29847
IN NAME OF

LAWRENCE A. COLLINS, JR.

Surveyed Sept. 13 1973, by D. NORBY